

INDEX OF SHEETS	
SHEET NO.	DESCRIPTION
1	COVER SHEET
2	FORT ST—GENERAL PLAN OF STRUCTURE
3	FORT ST—EXPANSION JOINT DETAILS
4	SPRUCE ST—GENERAL PLAN OF STRUCTURE
5	SPRUCE ST—EXPANSION JOINT DETAILS
6	W PORTAGE AVE—GENERAL PLAN OF STRUCTURE
7	W PORTAGE AVE—EXPANSION JOINT DETAILS
8	RIVERSIDE DR—GENERAL PLAN OF STRUCTURE
9	RIVERSIDE DR—SECTION
10	BINGHAM AVE—GENERAL PLAN OF STRUCTURE
11	BINGHAM AVE—EXPANSION JOINT DETAILS
12	JOHNSTON ST—GENERAL PLAN OF STRUCTURE
13	JOHNSTON ST—EXPANSION JOINT DETAILS
14	JOHNSTON ST—EXPANSION JOINT DETAILS

# CITY OF SAULT STE. MARIE

BRIDGE STRUCTURE NO.

FORT ST.: ST. NO. 1673  
SPRUCE ST.: ST. NO. 1675  
W. PORTAGE AVE.: ST. NO. 1679

RIVERSIDE DR.: ST. NO. 1676  
BINGHAM AVE.: ST. NO. 1677  
JOHNSTON ST.: ST. NO. 1678

PLANS OF PROPOSED BRIDGE PREVENTATIVE MAINTENANCE

## BRIDGE PREVENTATIVE MAINTENANCE



SECTIONS 5, 6 & 9, T47N – R1E, SAULT STE MARIE  
CHIPPEWA COUNTY, MICHIGAN

BID NUMBER: B-06-24

### UTILITIES

THE EXISTING UTILITIES LISTED BELOW AND SHOWN ON THESE PLANS REPRESENT THE BEST INFORMATION AVAILABLE AS OBTAINED ON OUR SURVEYS. THIS INFORMATION DOES NOT RELIEVE THE CONTRACTOR OF THE RESPONSIBILITY TO BE SATISFIED AS TO IT'S ACCURACY AND THE LOCATION OF EXISTING UTILITIES.

NAME OF OWNER	TYPE OF UTILITY
CITY OF SAULT MARIE ATTN: JIM MOREAU 1244 E. EASTERDAY AVENUE SAULT STE. MARIE, MI 49783 PHONE (906) 632-3531	WATER/SEWER SERVICE DEPARTMENT
CHARTER COMMUNICATIONS ATTN: CRAIG PURPLE, CONSTRUCTION COORDINATOR 2682 ASHMUN STREET SAULT STE. MARIE, MI 49783 PHONE (906) 635-3102 EXT: 13912 CELL (906) 440-1005 E-MAIL: craig.purple@charter.com	PHONE/INERNET/TV
DTE ENERGY ATTN: RICK ACKERMAN 1125 E. EASTERDAY AVENUE SAULT STE. MARIE, MI 49783 PHONE (906) 632-3330 CELL (906) 630 1066	NAT GAS
AT&T (SBC AMERITECH) ATTN: MIKE ANDERSON 310 W. 7TH AVENUE SAULT STE. MARIE, MI 49783 PHONE (906) 632-9901 CELL (906) 440-4478 E-MAIL: ma1421@att.com	PHONE/INERNET/TV
CLOVERLAND — POWER GENERATION ATTN: ROGER LINE 535 E PORTAGE AVE SAULT STE. MARIE, MI 49783 PHONE (906) 632-5171 CELL (906) 440-7612 E-MAIL: rline@cloverland.com	ELECTRIC
CLOVERLAND — ELECTRIC SERVICE ATTN: PAUL WARNER 2916 W M-28 DAFTER, MI 49724 PHONE (906) 632-5140 E-MAIL: pwarners@cloverland.com	ELECTRIC

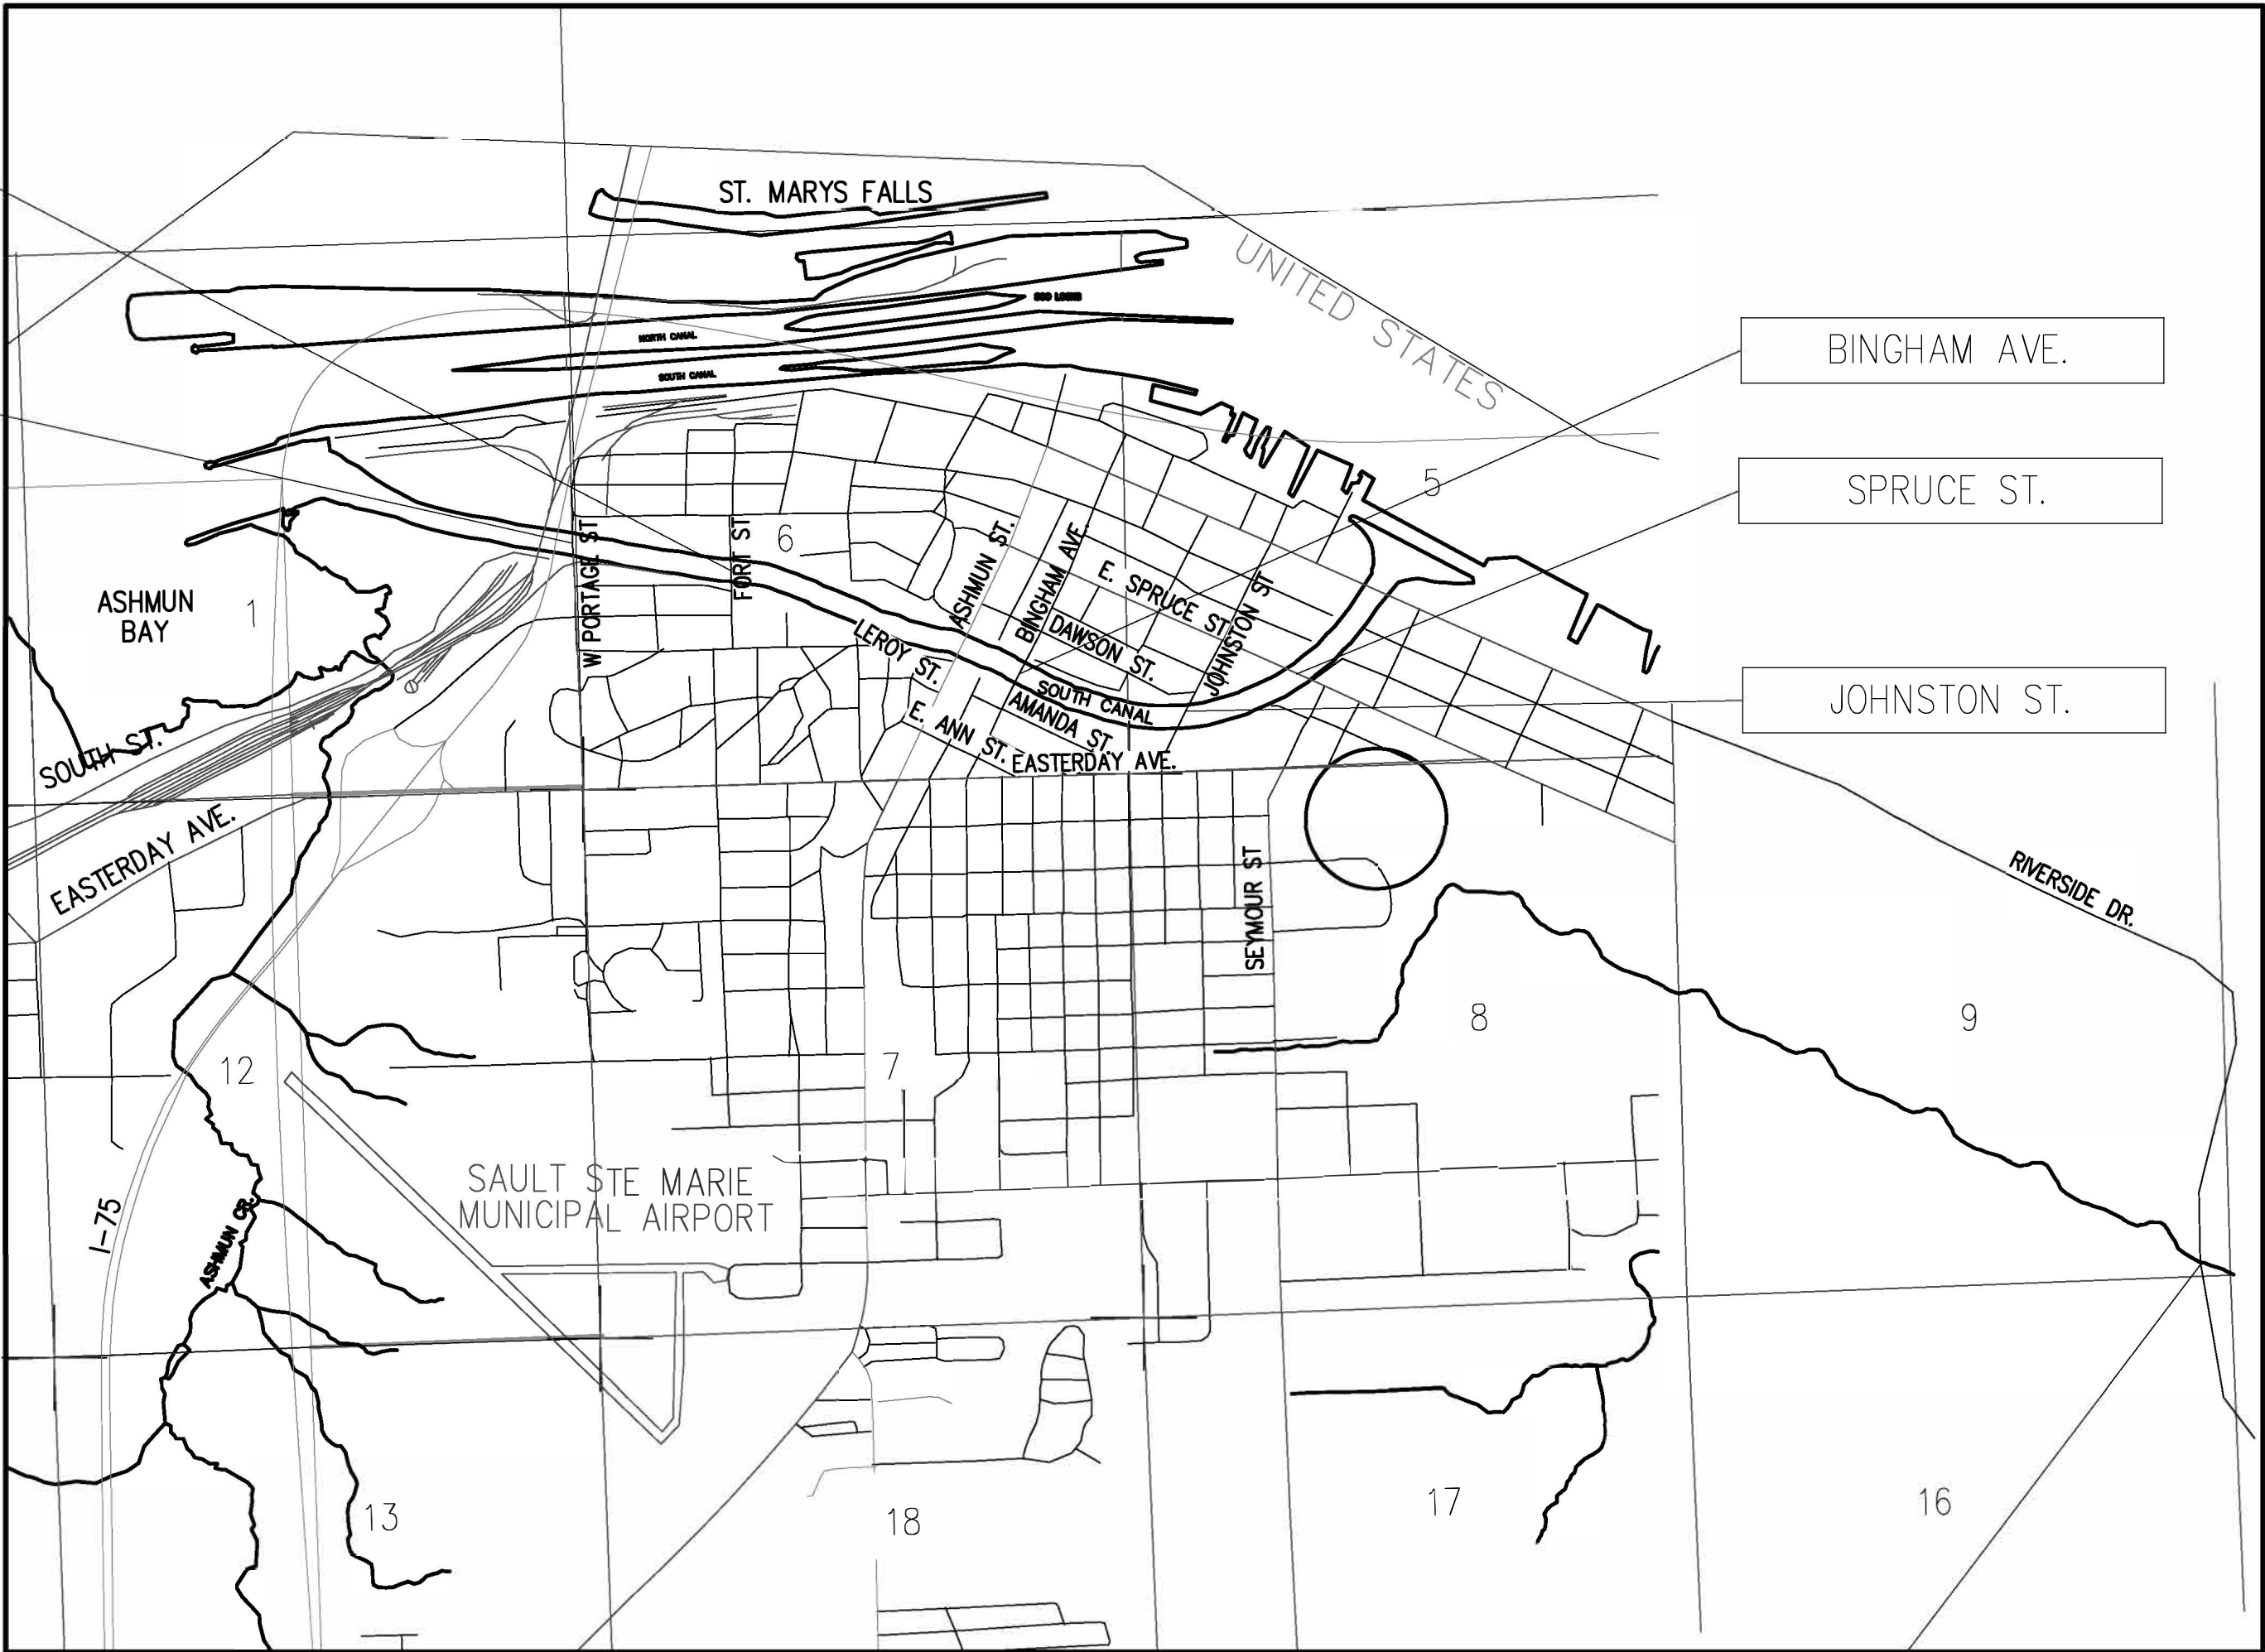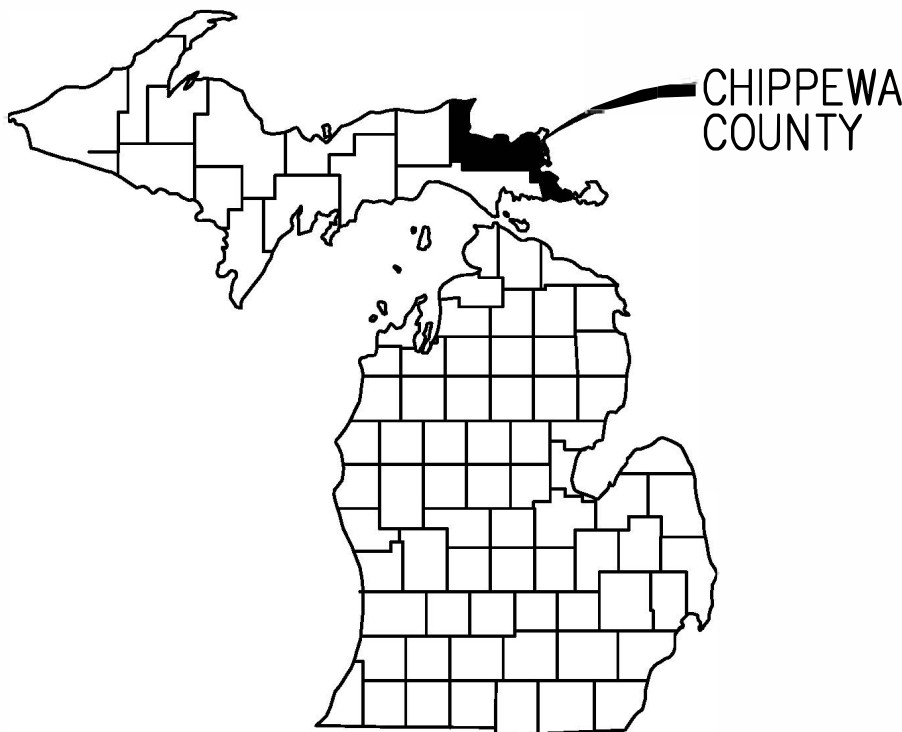

FINAL PLAN  
02.20.2024

LOCATION MAP  
N.T.S.



### GENERAL NOTES



EXCEPT WHERE OTHERWISE INDICATED ON THESE PLANS, OR IN THE PROJECT MANUAL AND SUPPLEMENTAL SPECIFICATIONS CONTAINED HEREIN, ALL MATERIALS AND WORKMANSHIP SHALL BE ACCORDING TO THE 2020 MICHIGAN DEPARTMENT OF TRANSPORTATION STANDARD SPECIFICATIONS FOR CONSTRUCTION EDITION.

ALL KEYNOTES, NOTES AND/OR MAINTENANCE INSTRUCTIONS INCLUDED IN THIS PROJECT ARE INDICATED IN RED.

PRINT IN COLOR


### SHEET KEYNOTES

- KEYNOTES ONLY APPLY TO THE SHEETS WHERE INDICATED. EVERY KEYNOTE DOES NOT OCCUR ON EVERY SHEET.
- ① CLEAN EXISTING EXPANSION JOINTS USING COMPRESSED AIR, WATER AND/OR VACUUM. COLLECT AND DISPOSE OF DEBRIS AND EFFLUENT. DO NOT CAUSE (FURTHER) DAMAGE TO JOINT COMPONENTS THAT ARE INTENDED TO REMAIN IN PLACE.
- ② REPAIR OR REPLACE EXISTING DAMAGED OR MISSING EXPANSION JOINT COVER PLATES AND ASSOCIATED HARDWARE. MATCH EXISTING CONSTRUCTION BASED ON FIELD MEASUREMENTS AND EXISTING DRAWINGS. REFER TO MDOT STANDARD PLAN EJ3AF AND SECTIONS 706.02 AND 706.03.K OF THE MDOT 2020 STANDARD SPECIFICATIONS FOR CONSTRUCTION. DO NOT CAUSE (FURTHER) DAMAGE TO JOINT COMPONENTS THAT ARE INTENDED TO REMAIN IN PLACE.
- ③ CLEAN EXISTING BRIDGE DECK AND SIDEWALKS USING COMPRESSED AIR, WATER AND/OR VACUUM. COLLECT AND DISPOSE OF DEBRIS AND EFFLUENT. DO NOT DAMAGE EXISTING CONCRETE, JOINT COMPONENTS AND FILLERS, SEALANTS, ETC.
- ④ ALL BRIDGE CLEANING AND REPAIRS SHALL BE PERFORMED WITH BRIDGES OPEN TO TRAFFIC. MAINTAIN A MINIMUM OF ONE LANE OPEN TO TRAFFIC IN EACH DIRECTION. WHERE TWO SIDEWALKS ARE PRESENT, MAINTAIN AT LEAST ONE SIDEWALK OPEN TO PEDESTRIAN TRAFFIC. PROVIDE ALL NECESSARY DEVICES AND MANPOWER TO SAFELY DIRECT TRAFFIC AROUND WORK ACTIVITIES (BARRELS, CONES, LIGHTS, FLAGGING, SIGNAGE, ETC.) IN COMPLIANCE WITH THE MANUAL ON UNIFORM TRAFFIC CONTROL DEVICES (MUTCD). PROVIDE A WRITTEN TEMPORARY TRAFFIC CONTROL PLAN FOR THE REVIEW AND APPROVAL OF THE ENGINEER WHERE LANE CLOSURES OR ADJUSTMENTS ARE ANTICIPATED. OBTAIN ANY NEEDED PERMITS AND COORDINATE ACTIVITIES WITH THE CITY OF SAULT SAINTE MARIE.
- ⑤ CLEAN EXISTING BRIDGE DRAINS BY PULLING UP GRATES AND VACUUMING AND/OR HAND CLEANING SEDIMENT AND DEBRIS FROM DRAINS. TO THE EXTENT POSSIBLE, COLLECT AND DISPOSE OF ACCUMULATED SEDIMENT AND DEBRIS. PROVIDE A FINAL FLUSH OF DRAINS WITH POTABLE WATER AND REPLACE GRATES.
- ⑥ ADJUST SURFACE ELEVATION OF EXISTING APPROACH SIDEWALK TO MATCH END OF SIDEWALK ON BRIDGE. GRIND FULL WIDTH OF EXPOSED BACKWALL TO MINIMIZE SLOPE. SEE DETAIL ON SHEET 2.
- ⑦ REMOVE DEBRIS AND SEDIMENT AT BEARING SEAT ON BRIDGE ABUTMENTS AND DISPOSE OF ACCUMULATED DEBRIS AND SEDIMENT. CLEAN ADJACENT BEARINGS WITH COMPRESSED AIR AND/OR WATER TO ENSURE BEARING FUNCTIONALITY.
- ⑧ REPLACE MISSING SCREWS, WASHERS AND LOCK WASHERS ON EXISTING STREET LIGHT BASE HANDHOLE COVERS. IF EXISTING THREADS ARE DAMAGED, DRILL OUT AND RETAP TO LARGER SCREW SIZE. TIGHTEN EXISTING LOOSE SCREWS AND ANCHOR BOLT COVERS, REPLACING SCREWS IF MISSING. ALL SCREWS, WASHERS AND LOCK WASHERS SHALL BE STAINLESS STEEL COMPLYING WITH MDOT 2020 STANDARD SPECIFICATIONS FOR CONSTRUCTION SECTION 918.08.


CONTRACT FOR: CLEANING AND PREVENTATIVE MAINTENANCE.	
CITY OF SAULT STE. MARIE APPROVAL	
CITY ENGINEER	Date
 Advancing Communities 2940 Parkview Drive   Petoskey, MI 49770 p (231) 344-1150   f (734) 522-6427	
PREPARED UNDER THE SUPERVISION OF:	
	6201044654 Registration No.
JAMES E. RINTALA, P.E.	Date
REVISIONS	
PROJECT NO. 7706.23.0060	SHEET NO. 1 OF 14




DRAWING PATH: P:\7700\_7799\7799\230060\_SSM\_Bridge\_Maintenance\_Drawings\Drawings\Civil\Plans\_Const\230060FORT.dwg Mar 01, 2024 1:20pm

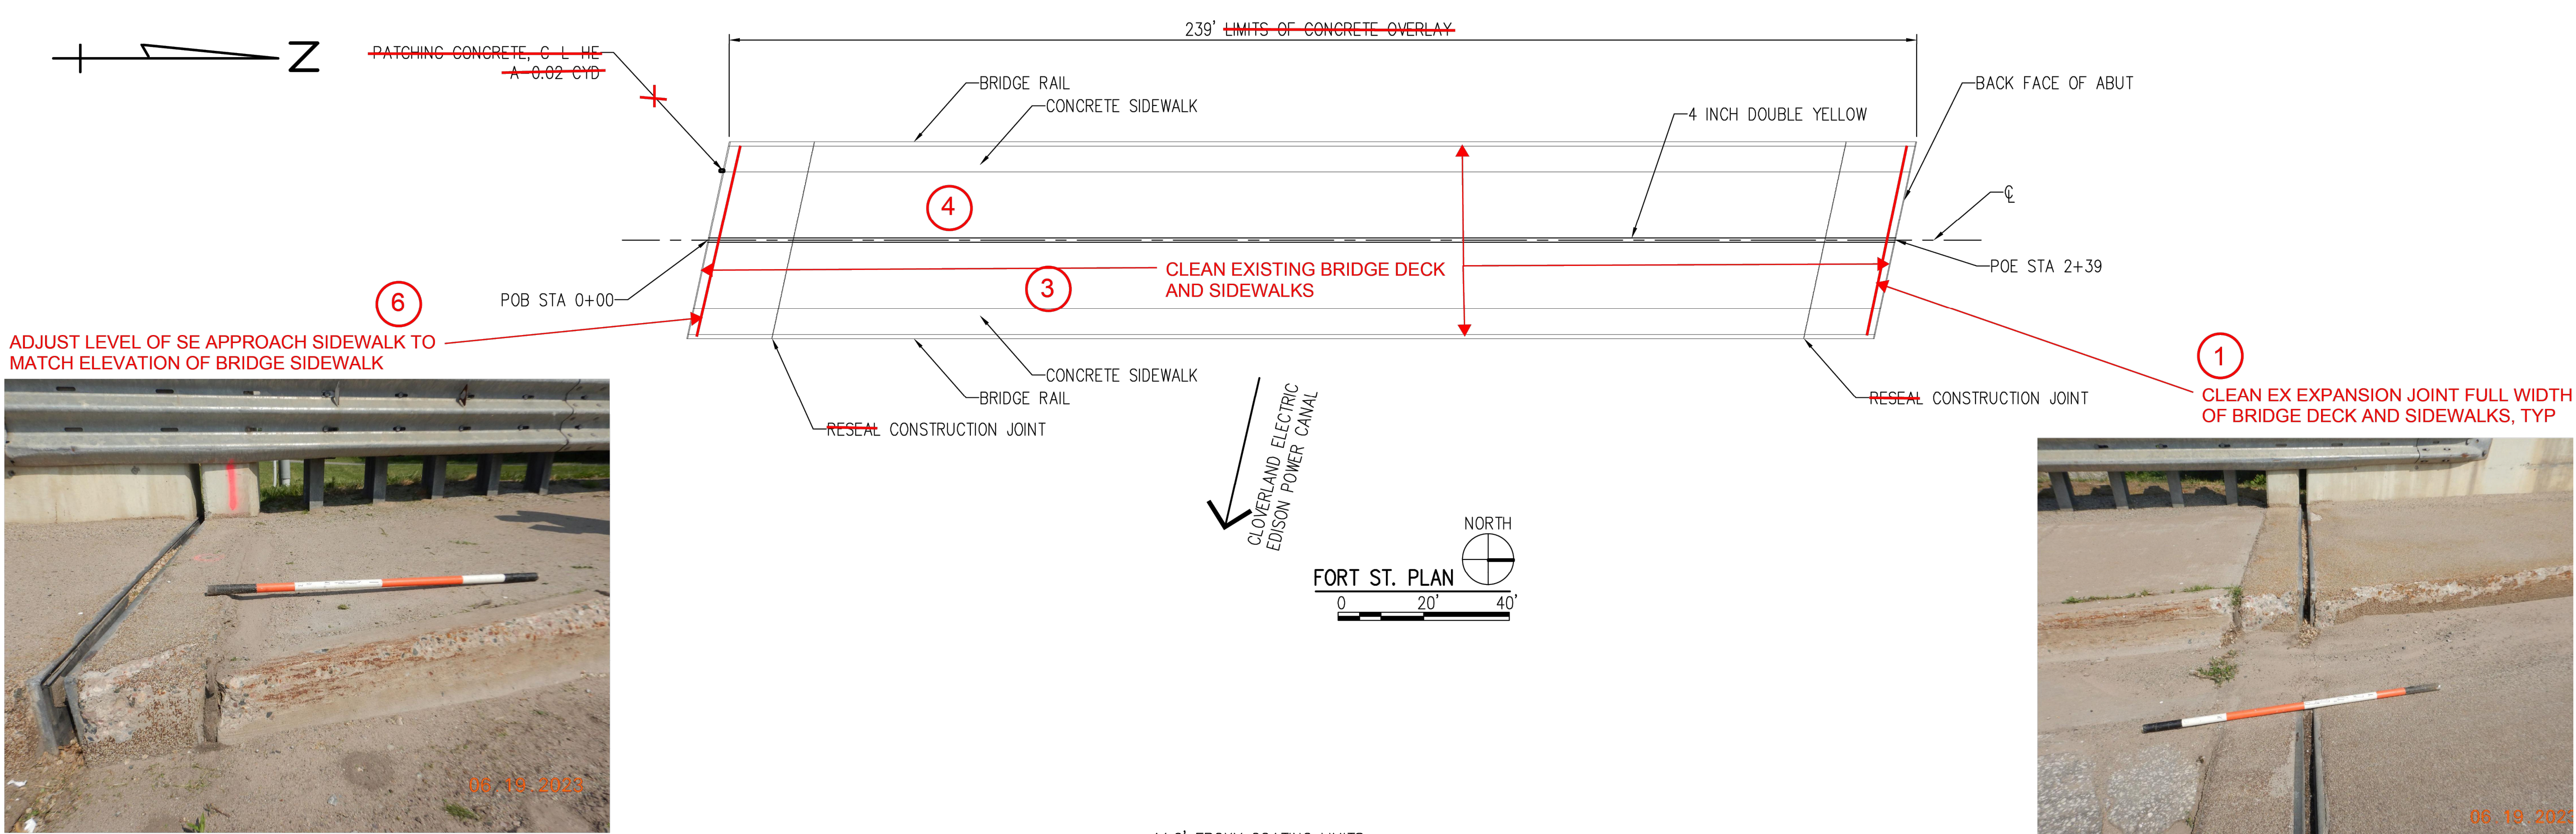

Document Name: DSCN0057.JPG  
Category: Approach  
Span Number:  
Comments: Settlement of southeast approach sidewalk.

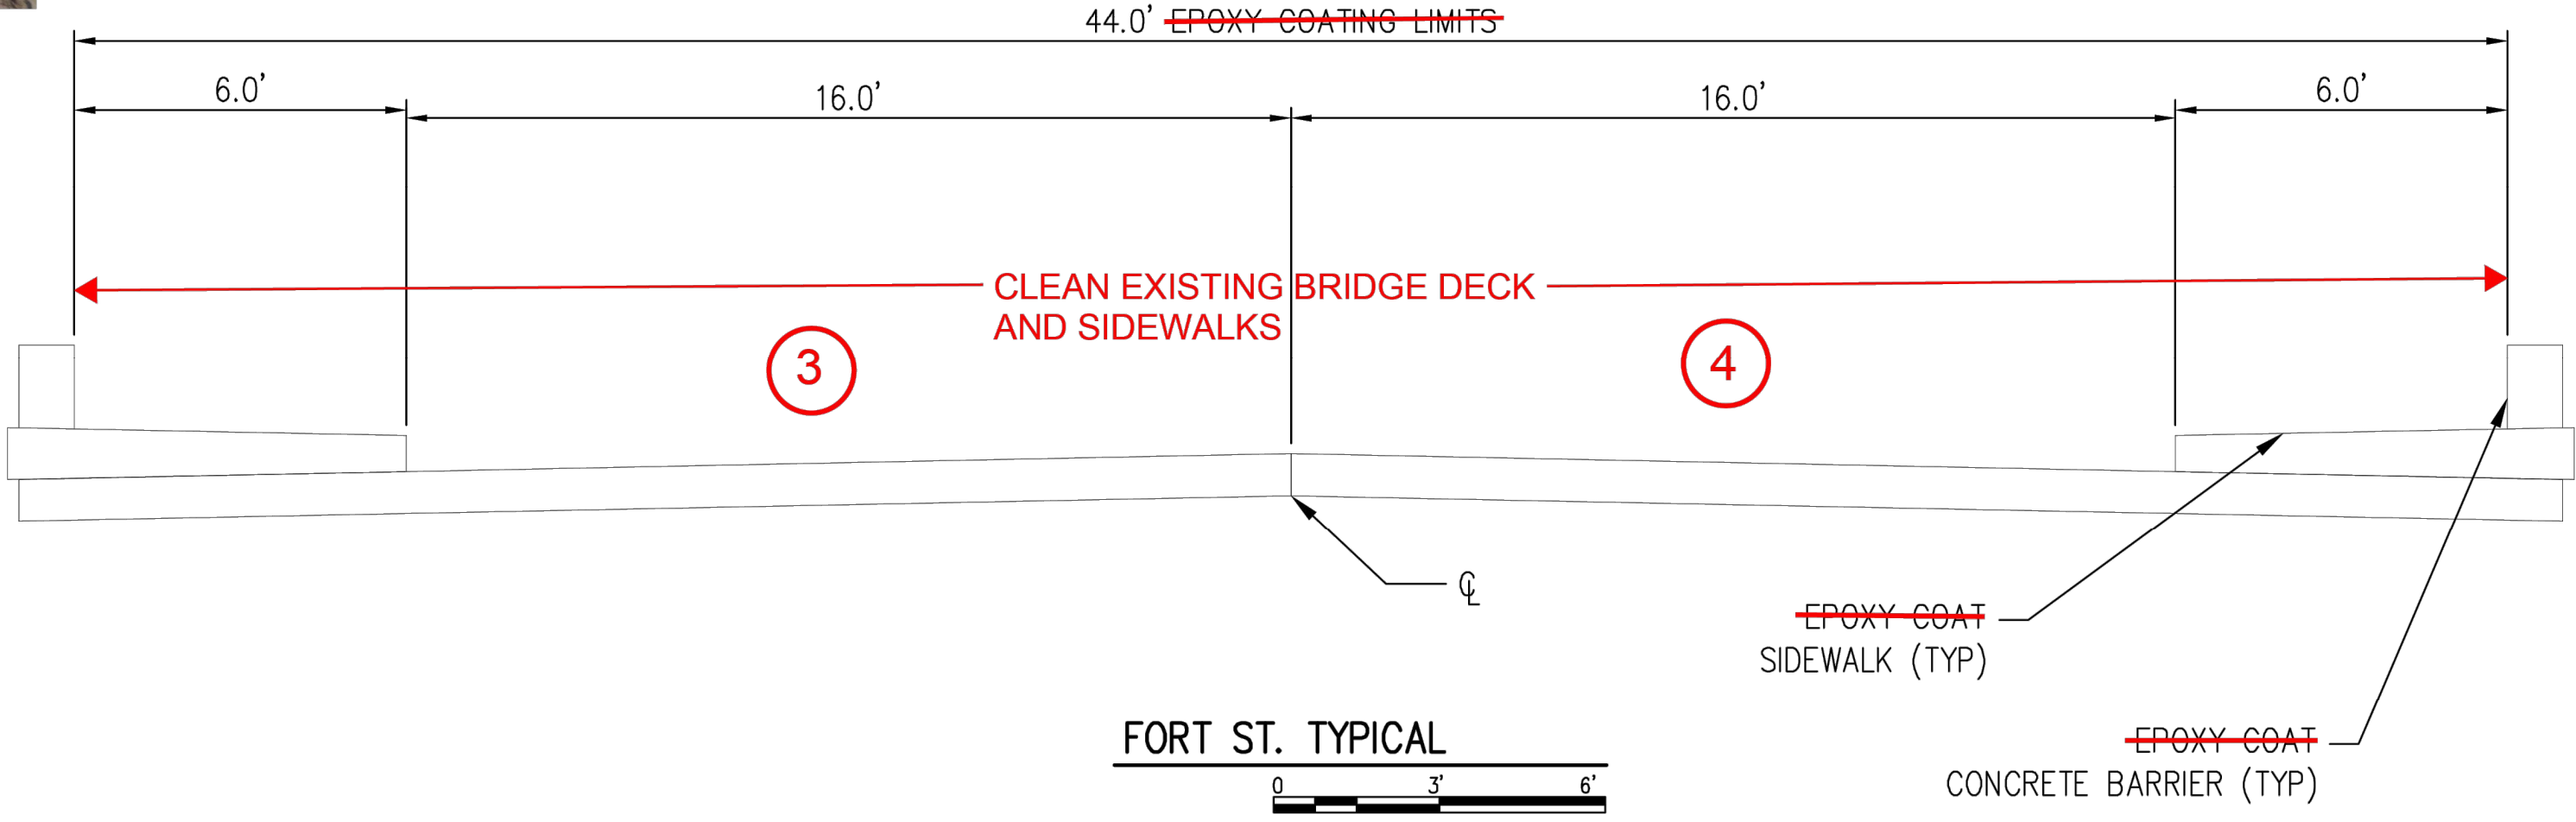

Document Name: DSCN0052.JPG  
Category: Approach  
Span Number:  
Comments: Approach expansion joint filled with sediment at the shoulders.

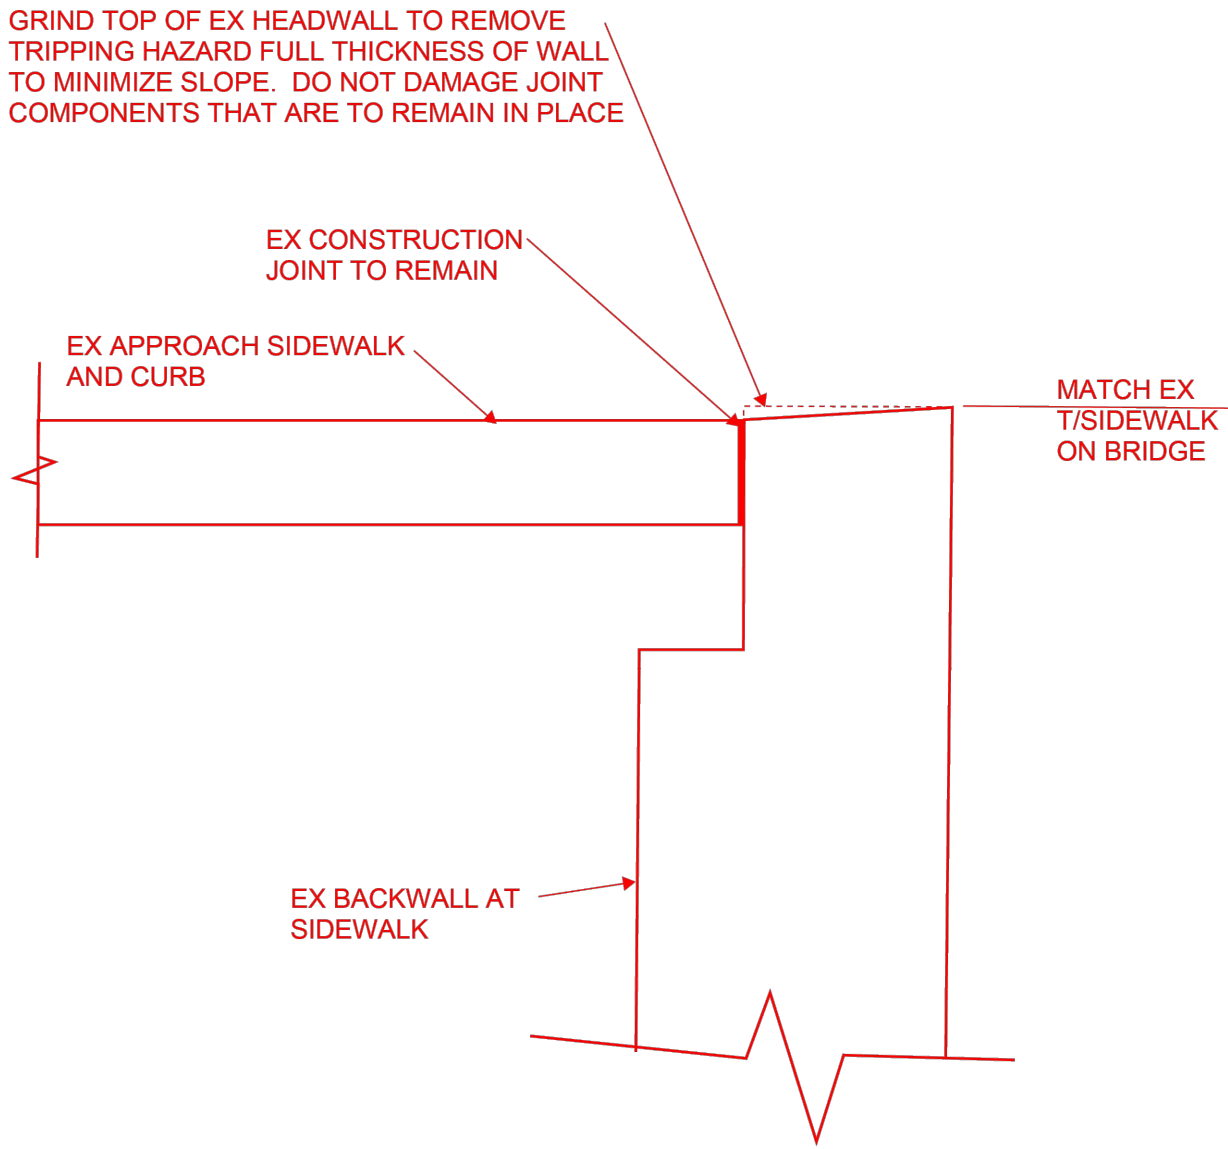

DETAIL - SIDEWALK REPAIR

ARCHITECTS ENGINEERS PLANNERS  
OHM-ADVISORS.COM

ISSUED FOR: CONSTRUCTION	02.20.24	DATE
REVISION	DESCRIPTION	

PROJECT NUMBER  
7799.23.0060

PM  
AP





CITY OF SAULT STE MARIE  
SAULT STE MARIE BRIDGE MAINTENANCE  
SAULT STE MARIE, MI  
FORT ST-GENERAL PLAN OF STRUCTURE

2

COPYRIGHT 2023 OHM ADVISORS. ALL DRAWINGS AND WRITTEN MATERIALS APPEARING HEREIN CONSTITUTE THE ORIGINAL AND UNPUBLISHED WORK OF OHM ADVISORS AND THE SAME MAY NOT BE DUPLICATED, DISTRIBUTED OR DISCLOSED WITHOUT PRIOR WRITTEN CONSENT OF OHM ADVISORS



DRAWING PATH: P:\7700 7799\770623060 SSM Bridge Maintenance Drawings\Civil\Plans Const\230606\FORT.dwg    Mar 01, 2024 - 1:20pm

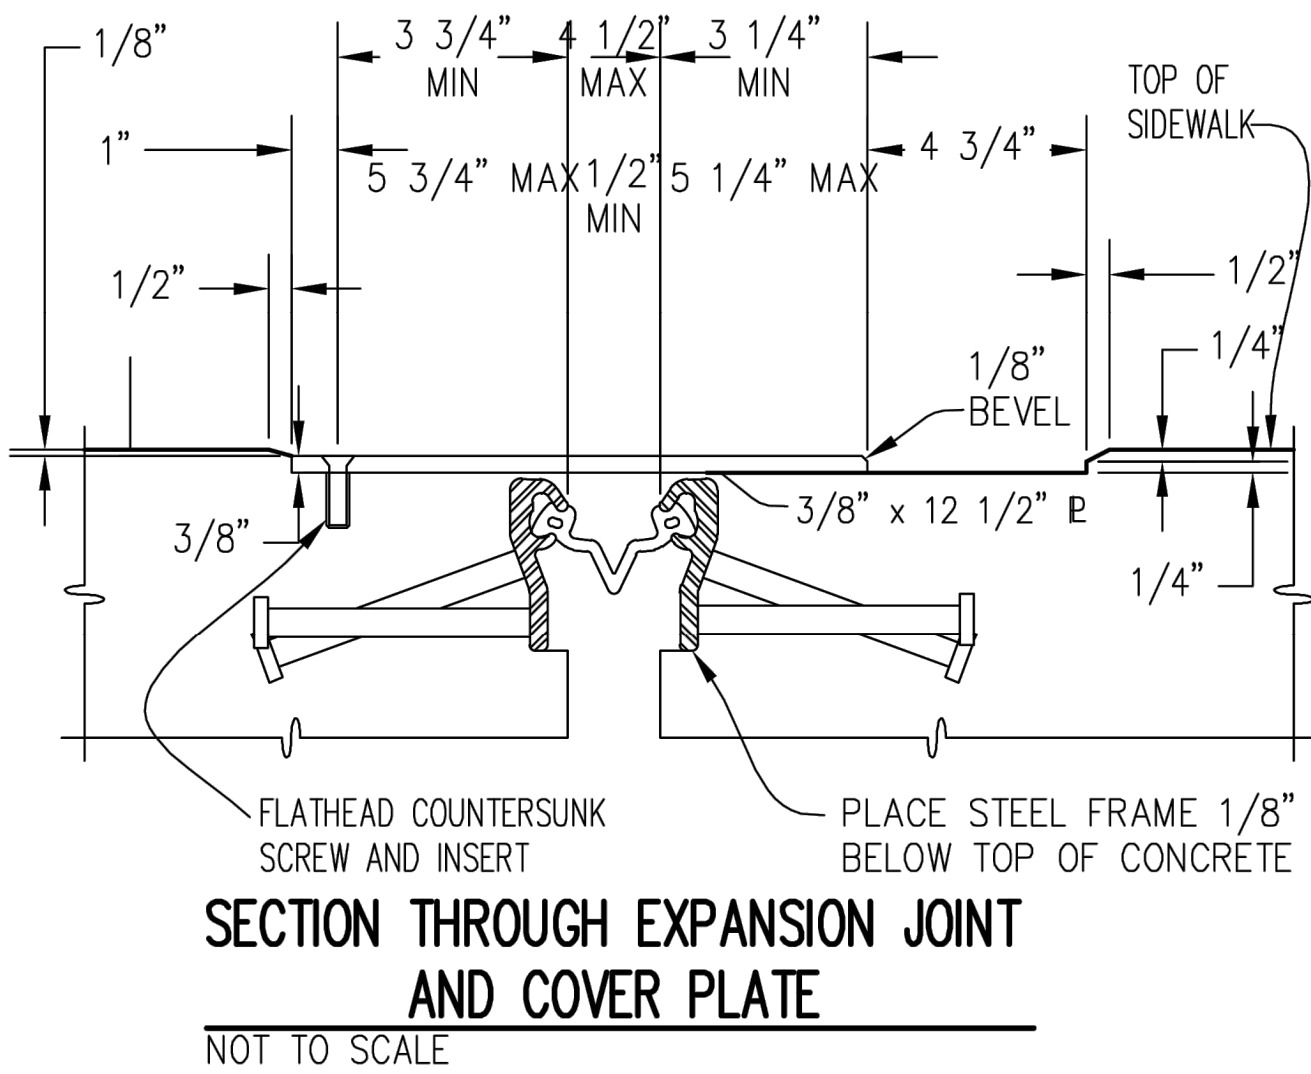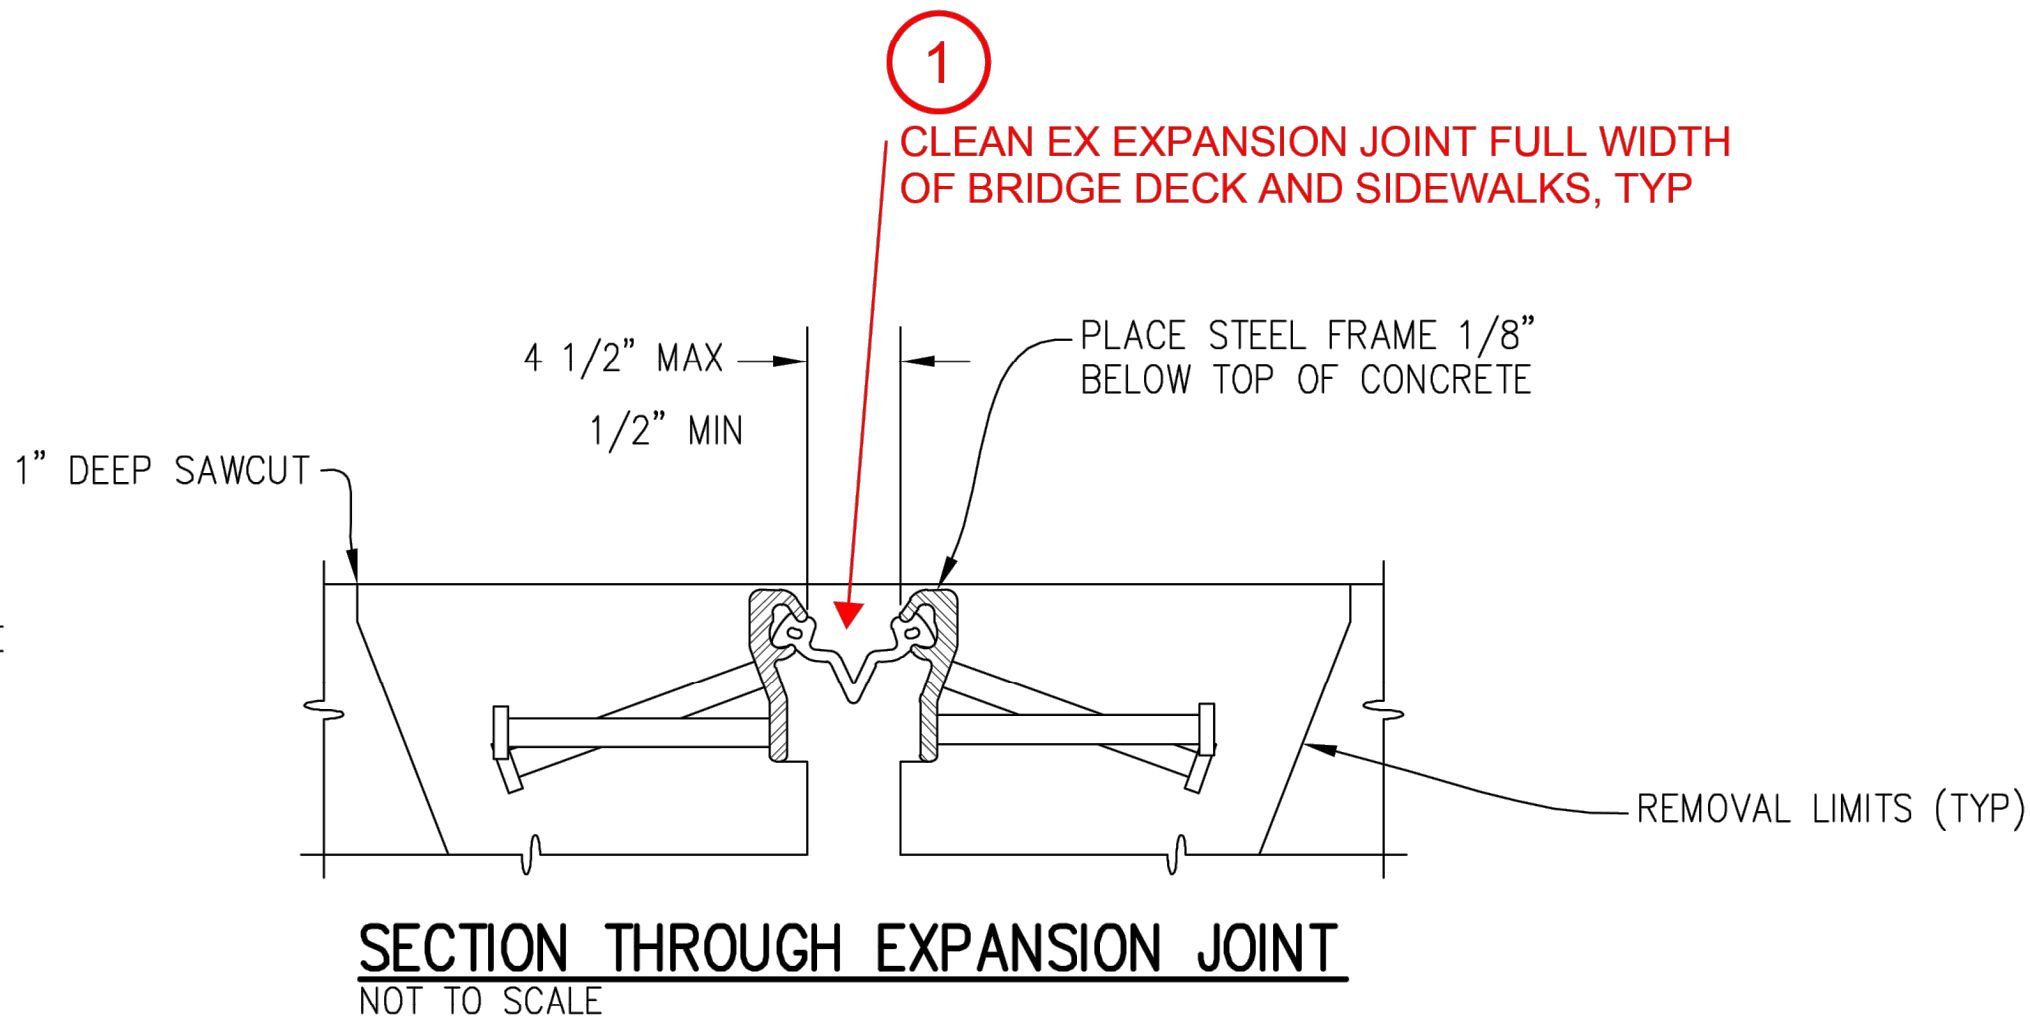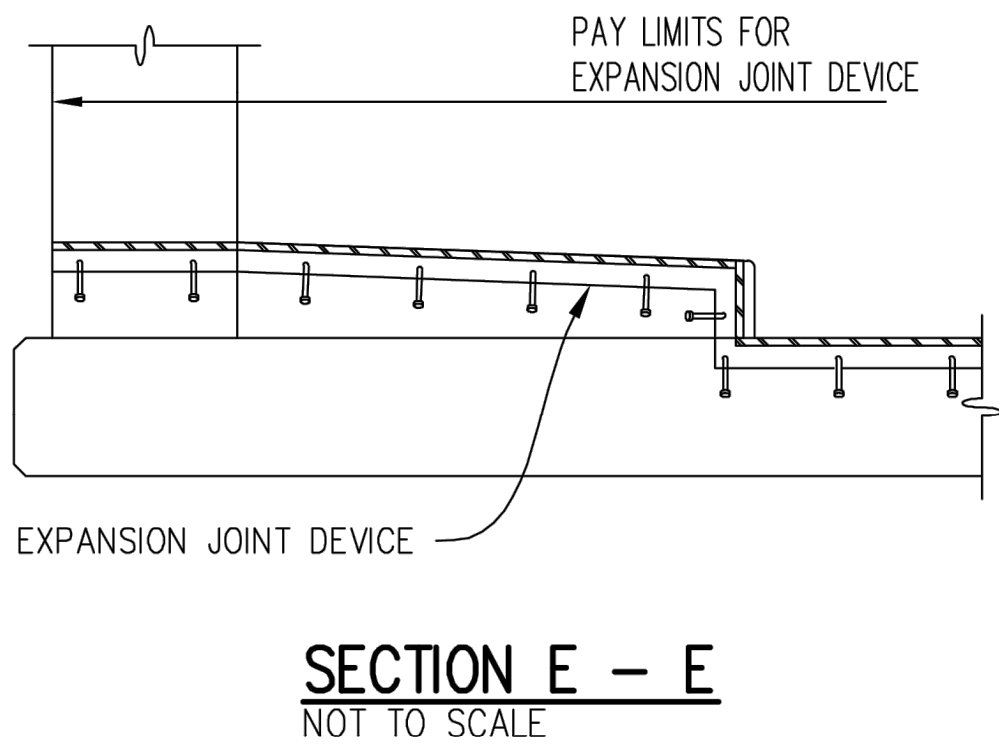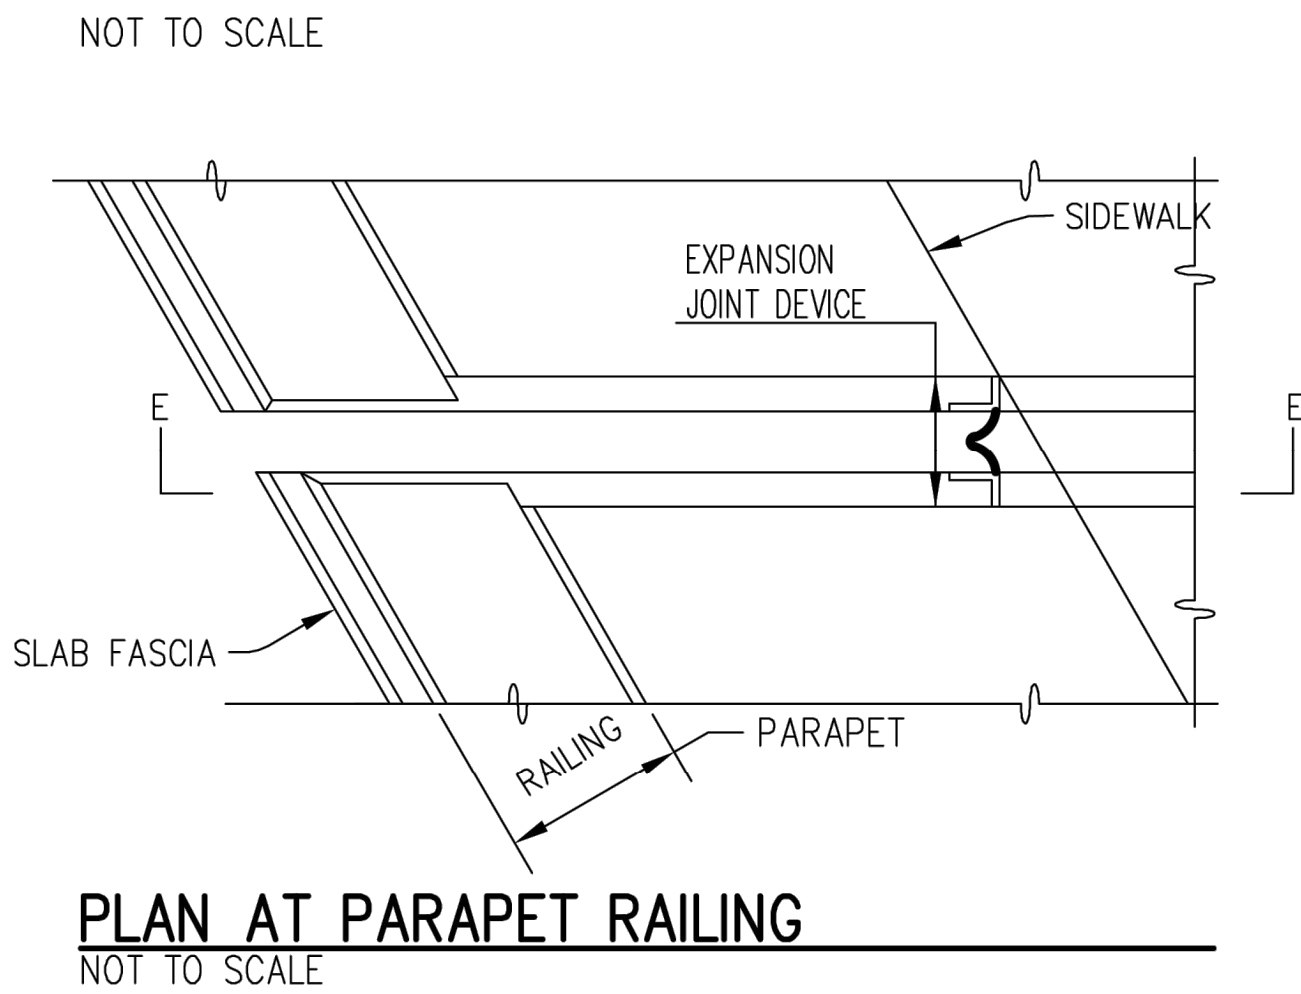

ISSUED FOR:	CONSTRUCTION	02/20/24
REVISION	DESCRIPTION	DATE
...		





DRAWING PATH: P:\7700 7799\7702\3060 SSM Bridge Maintenance Drawings\Civil\Plans Const\230606SPRUCE.dwg Mar 01, 2024 - 1:20pm

Document Name: DSCN0092.JPG  
Category: Deck  
Span Number:  
Comments: Typical deck drains filled with sediment.



CLEAN EX DECK DRAINS, TYP


5

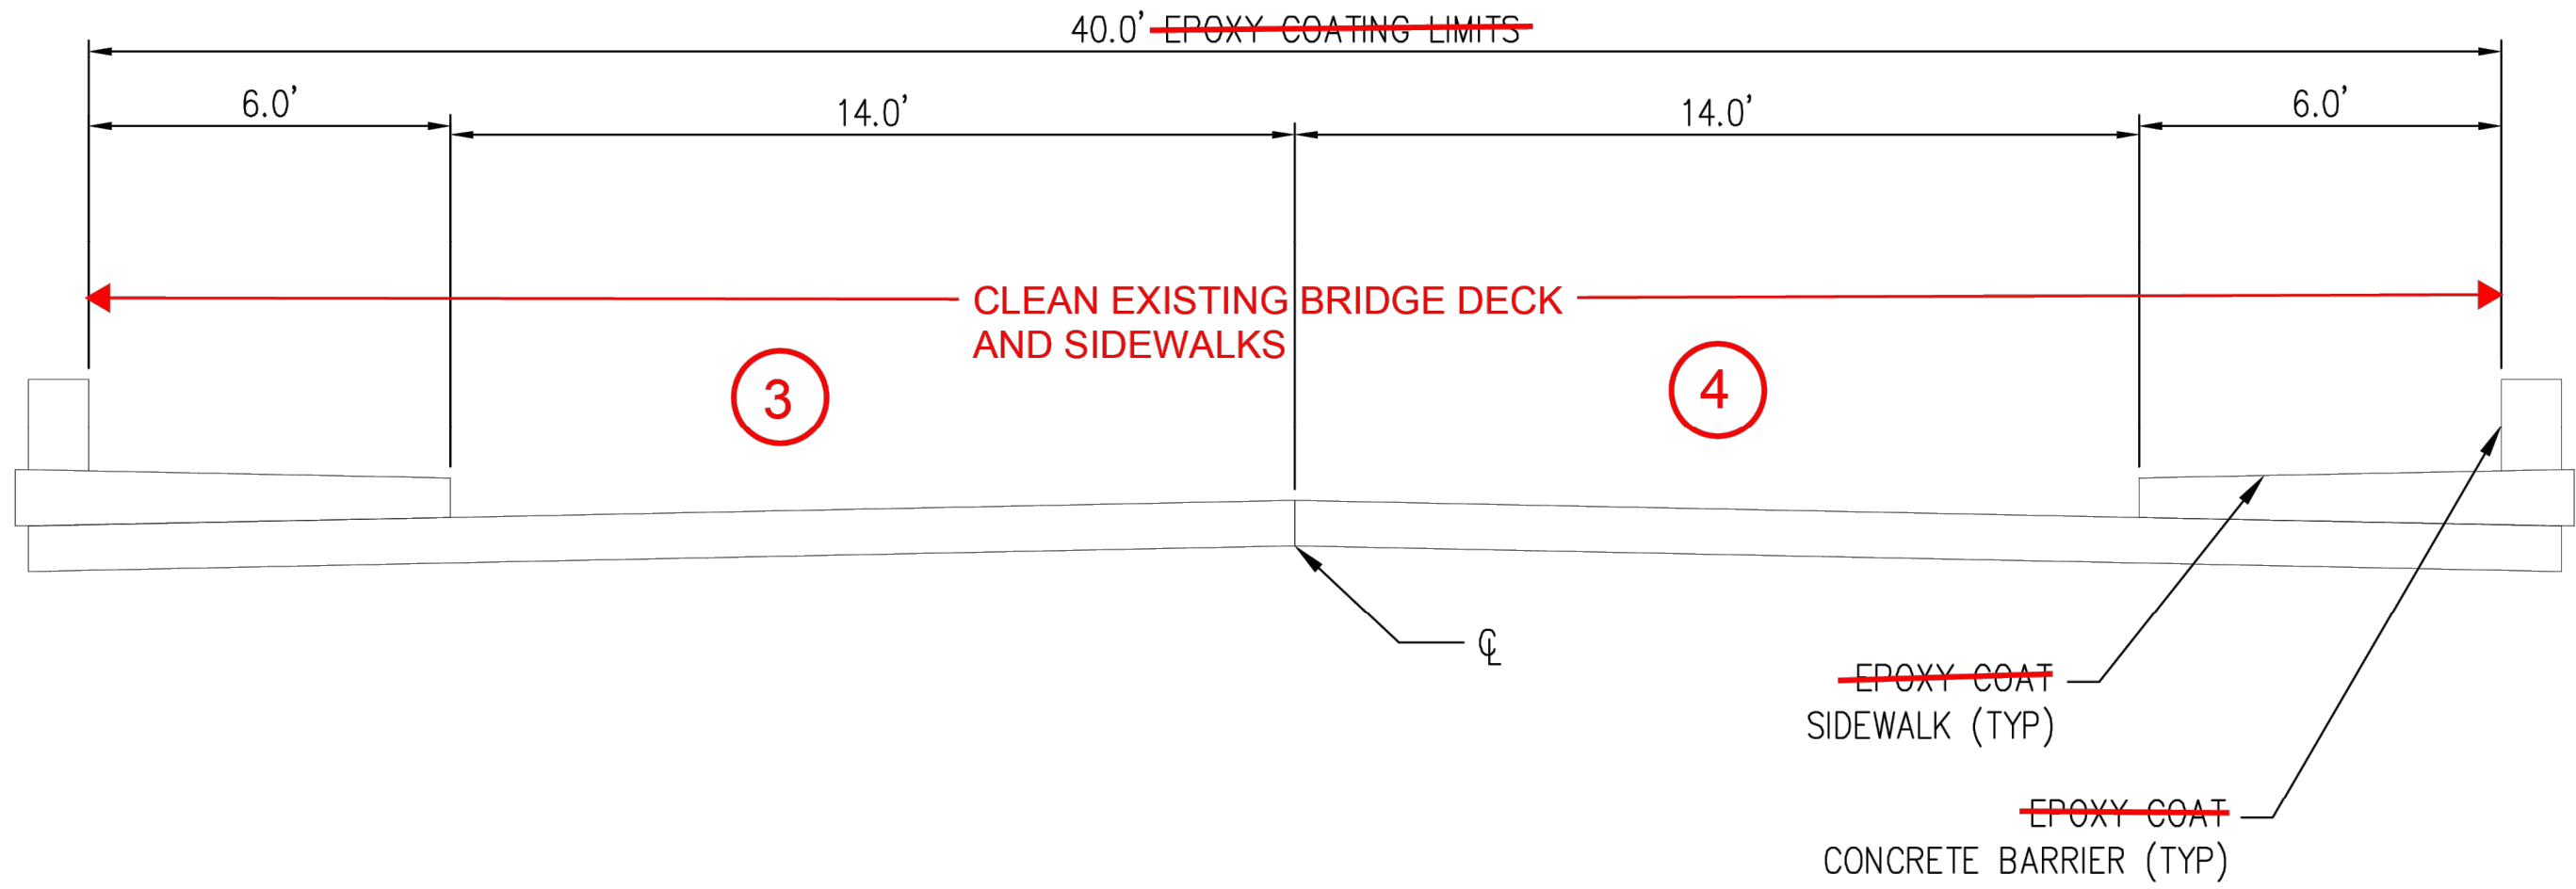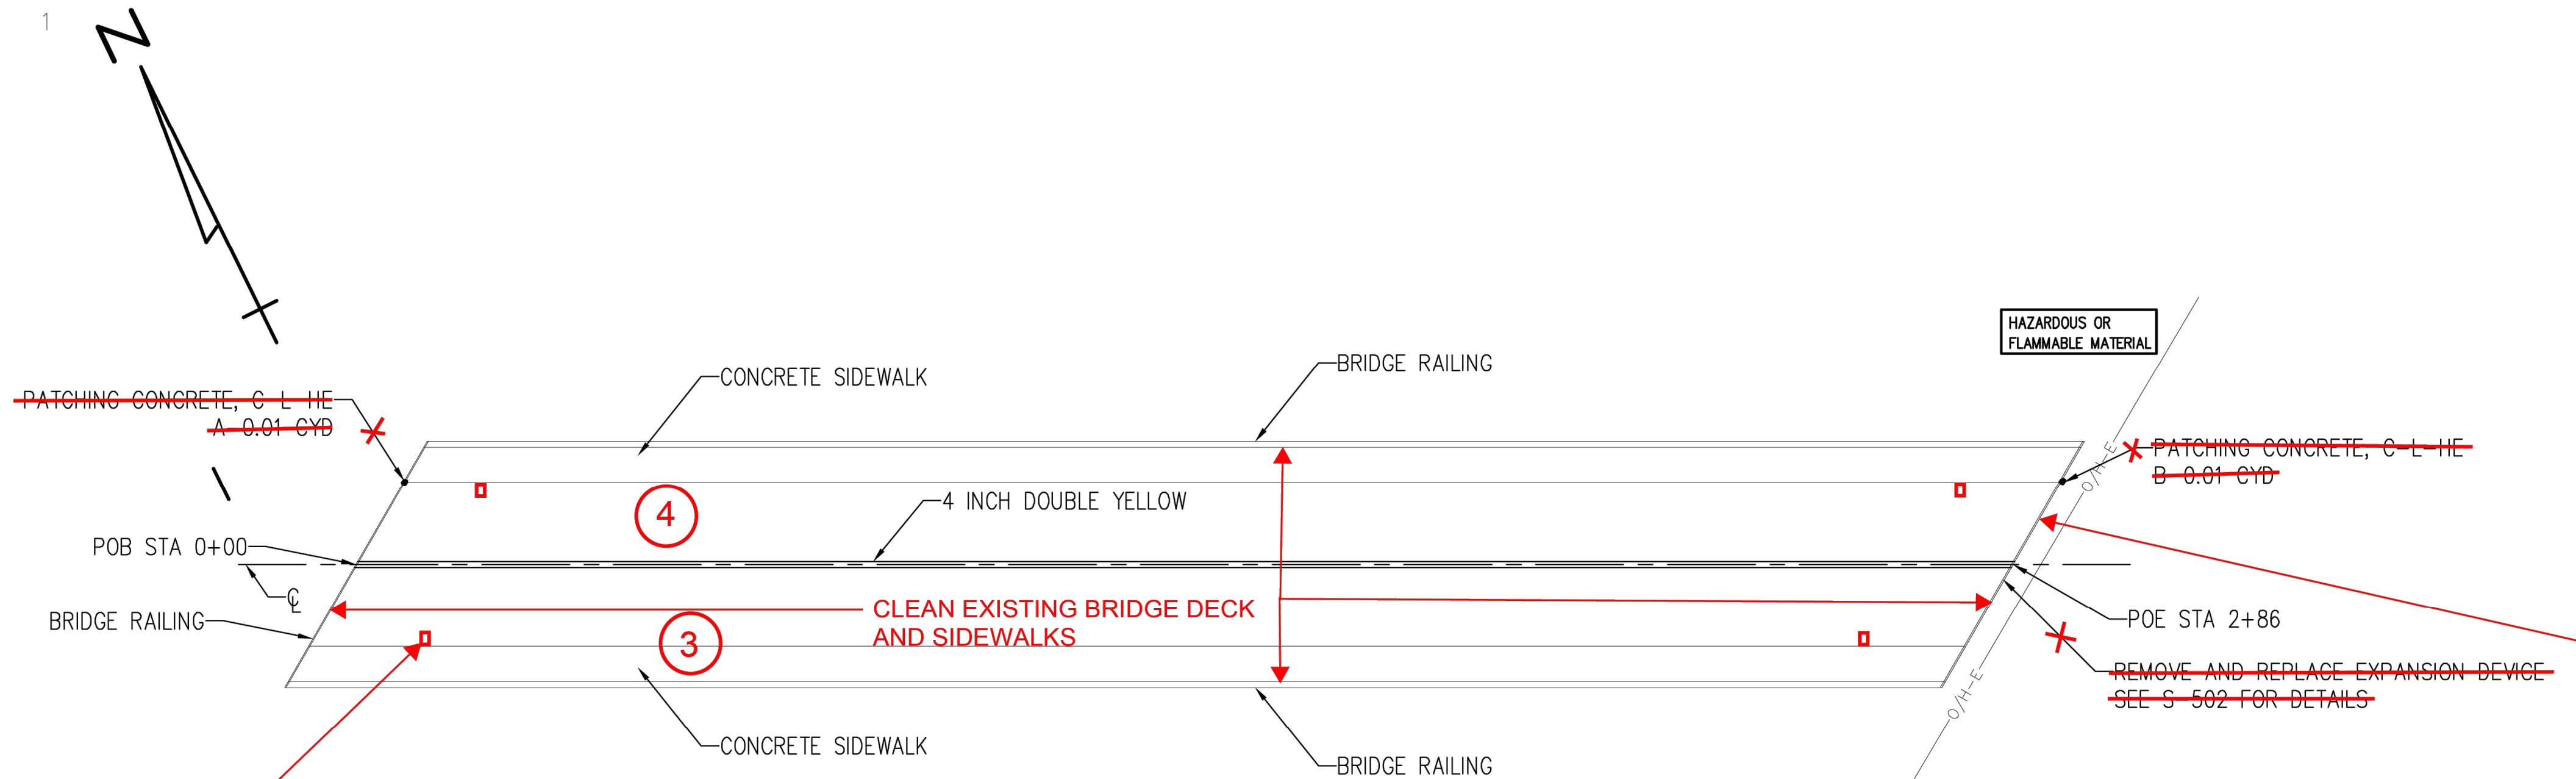

Document Name: DSCN0094.JPG  
Category: Joints  
Span Number:  
Comments: Typical expansion joint filled with sediment.



1  
CLEAN EX EXPANSION JOINT FULL WIDTH OF BRIDGE DECK AND SIDEWALKS, TYP




ARCHITECTS ENGINEERS PLANNERS  
OHM-ADVISORS.COM

PROJECT NUMBER 7702.23.0060	PM AP	CITY OF SAULT STE MARIE SAULT STE MARIE BRIDGE MAINTENANCE SAULT STE MARIE, MI SPRUCE ST-GENERAL PLAN OF STRUCTURE	
ISSUED FOR: CONSTRUCTION	REVISION	DESCRIPTION	DATE
			02/20/24


4




DRAWING PATH: P:\7700 7799\770623060 SSM Bridge Maintenance Drawings\Civil\Plans Const\230606SPRUCE.dwg    Mar 01, 2024 - 1:20pm

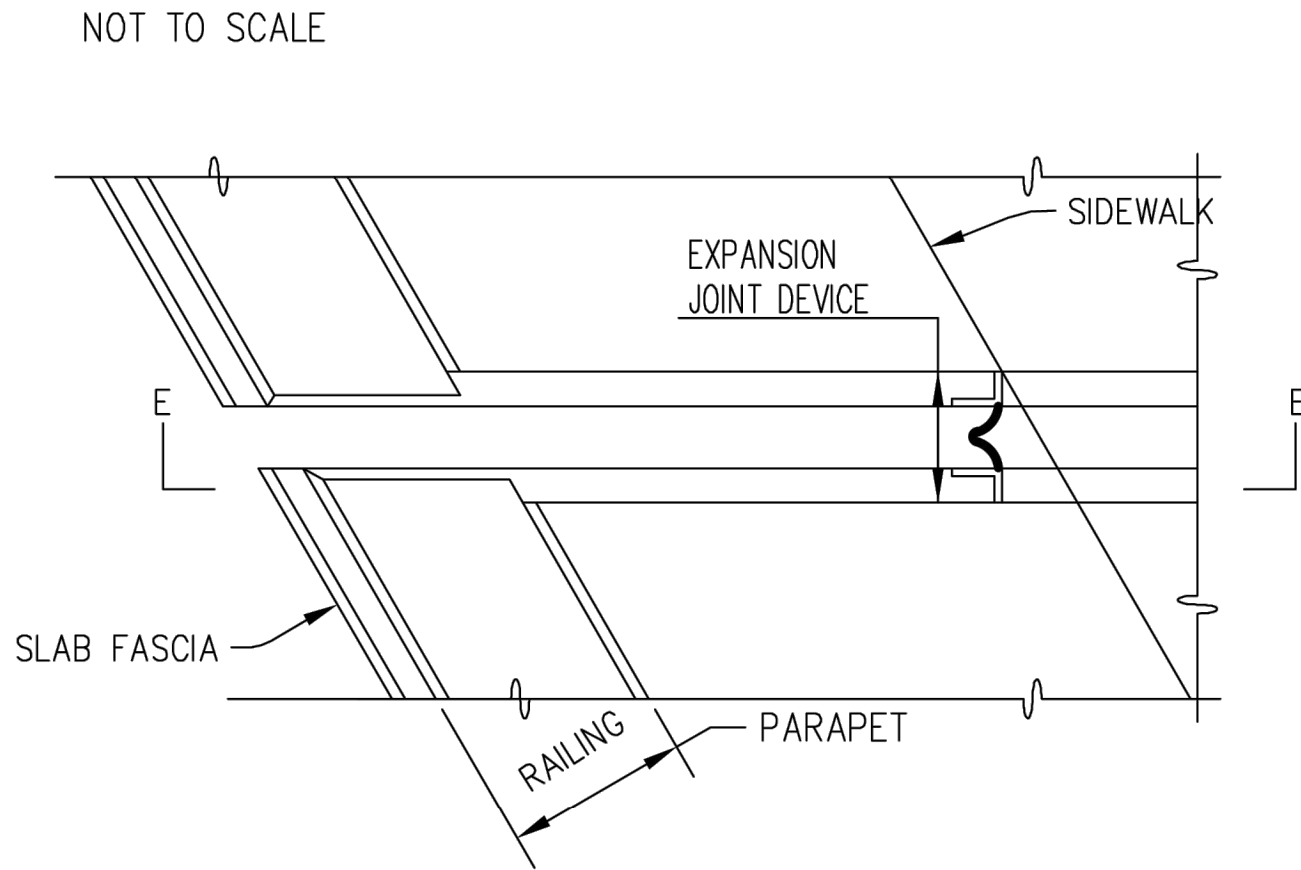


**PLAN AT PARAPET RAILING**  
NOT TO SCALE

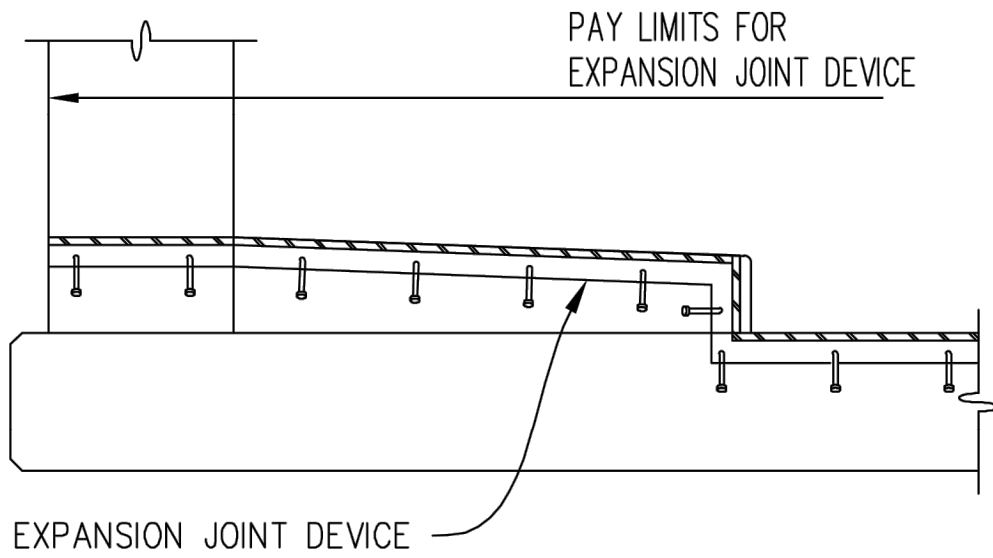

**SECTION E – E**  
NOT TO SCALE

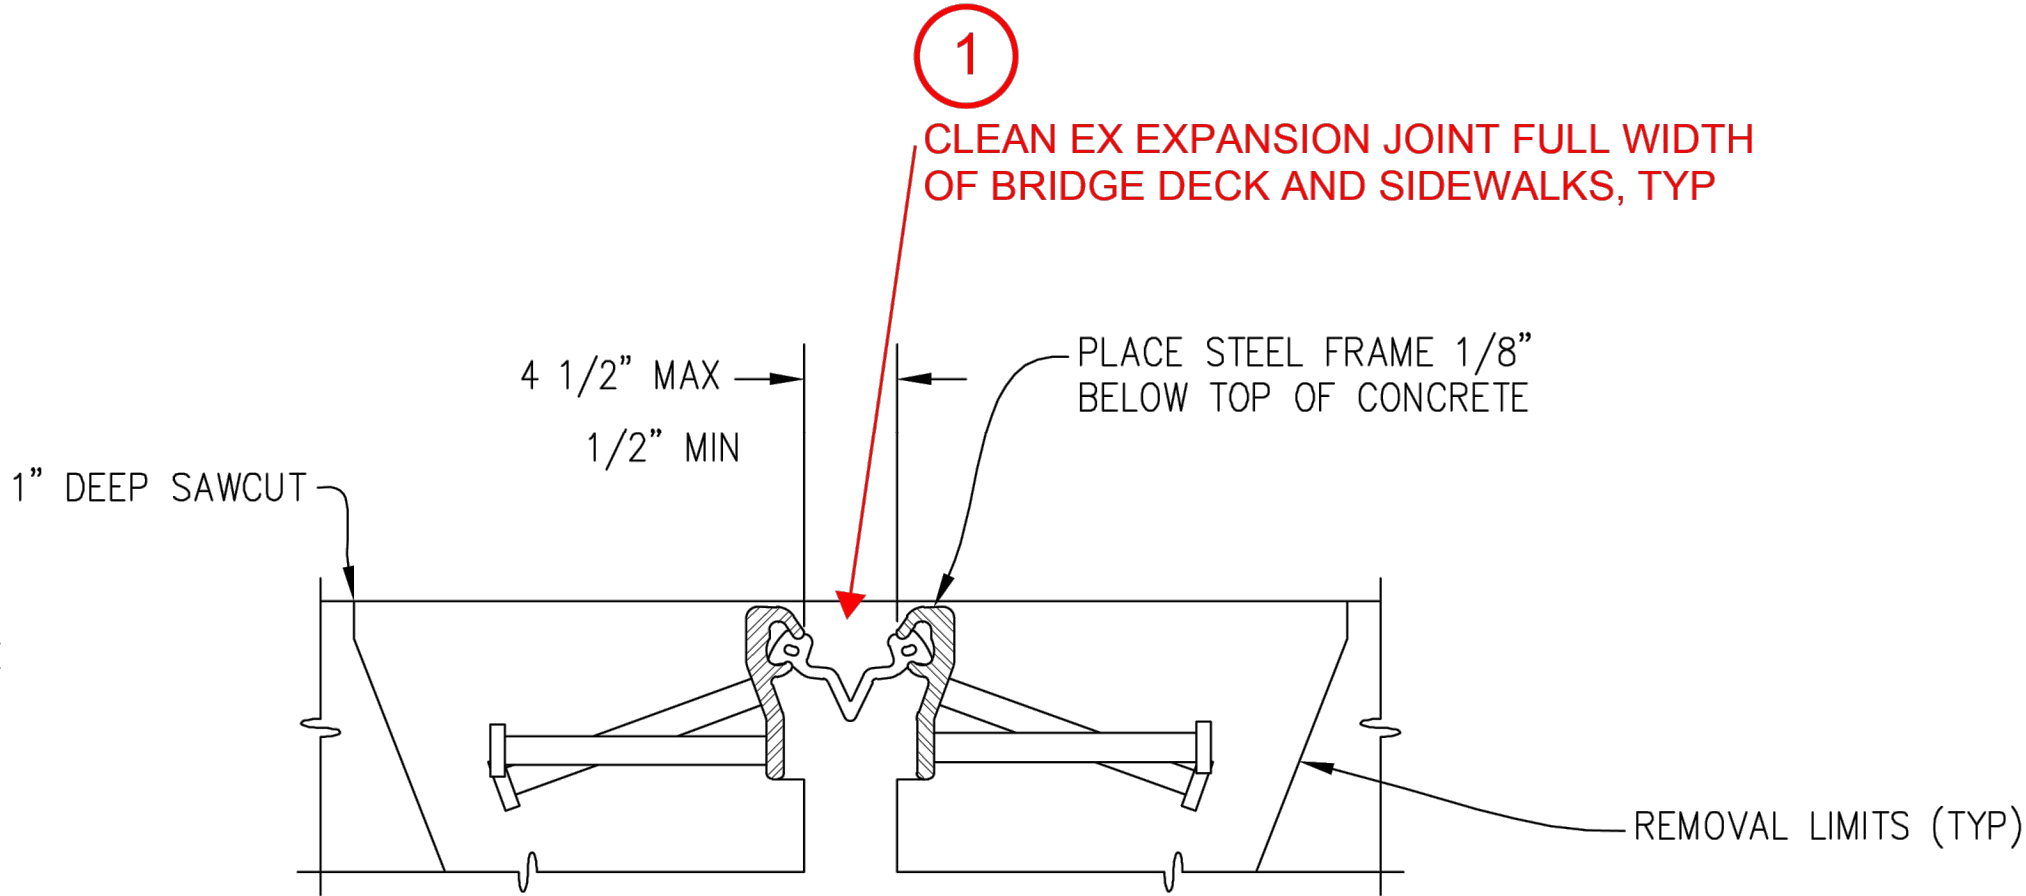

**SECTION THROUGH EXPANSION JOINT**  
NOT TO SCALE

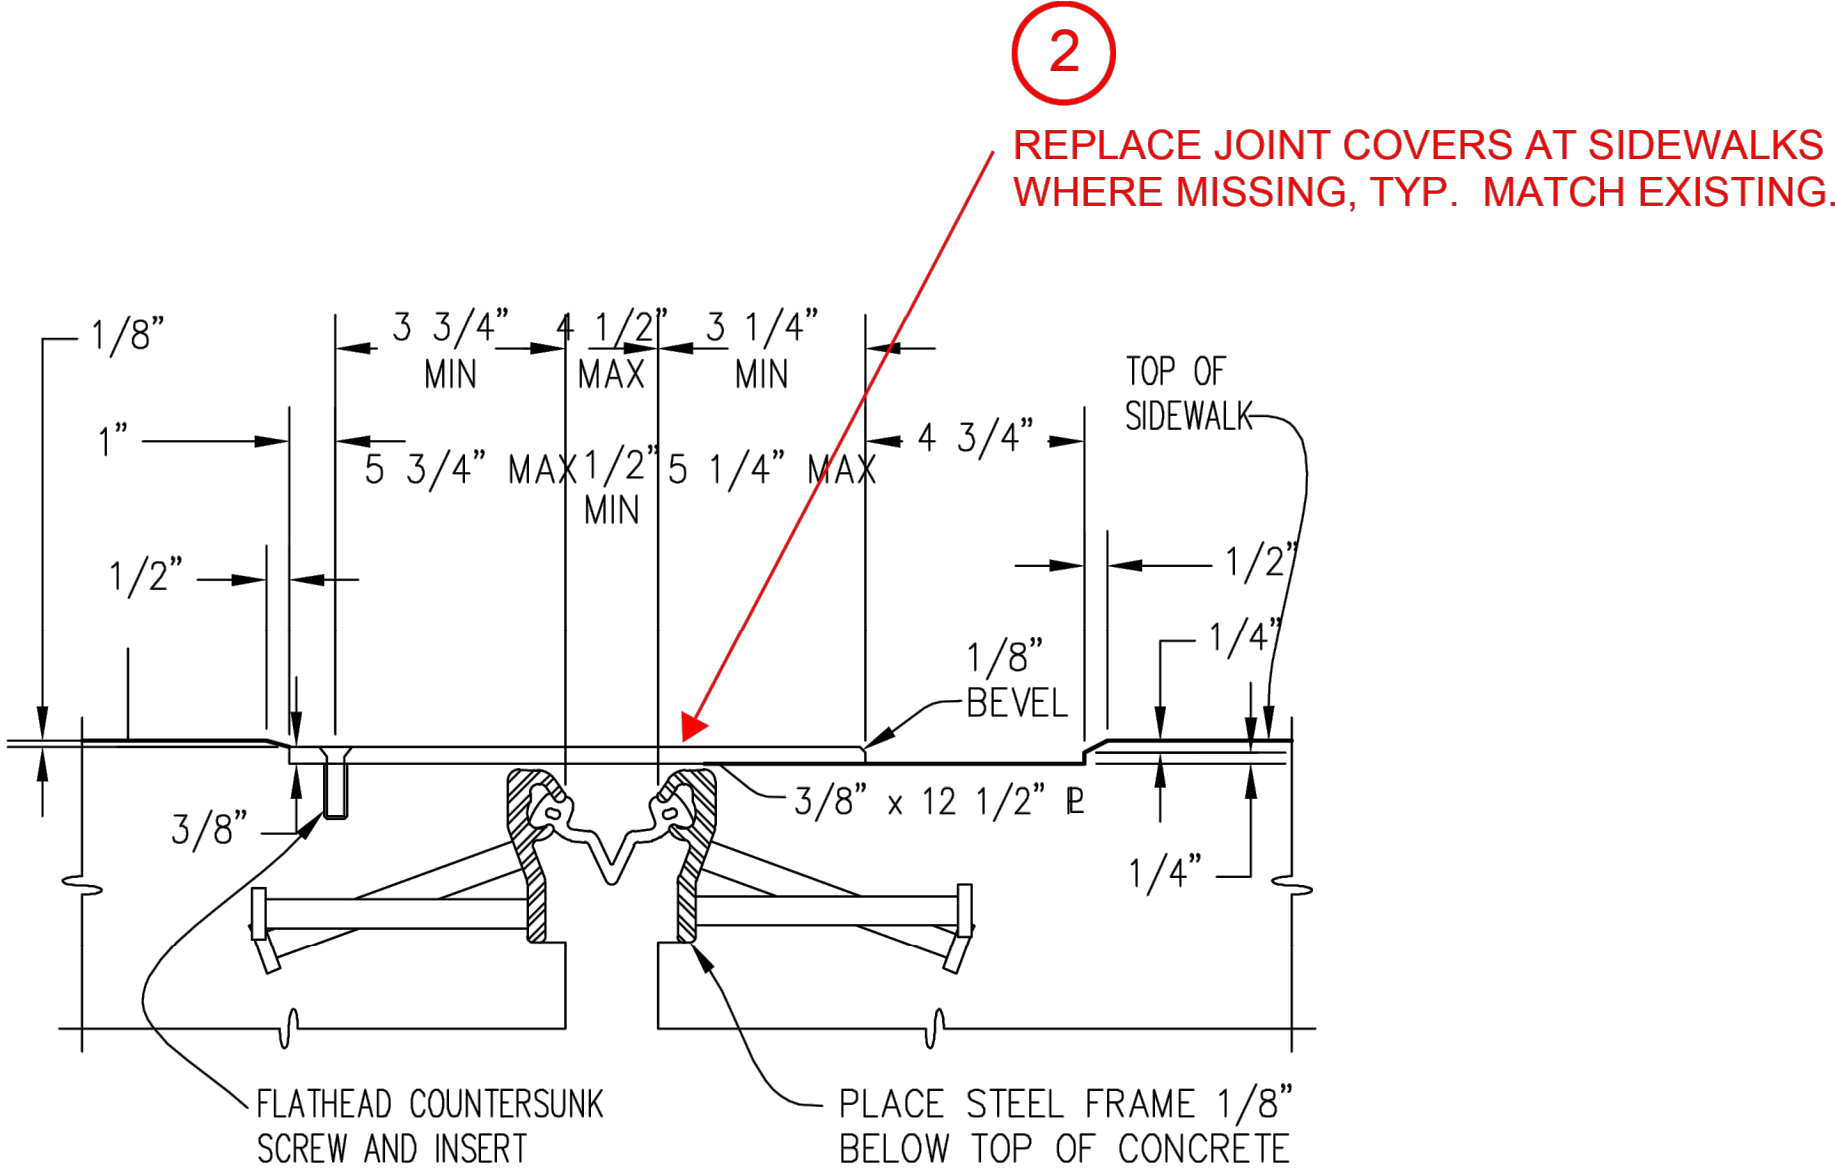


**SECTION THROUGH EXPANSION JOINT AND COVER PLATE**  
NOT TO SCALE

ISSUED FOR:	CONSTRUCTION	02/20/24
REVISION	DESCRIPTION	DATE
...		


PROJECT NUMBER	PM
770623.0060	AP
CITY OF SAULT STE MARIE	
SAULT STE MARIE BRIDGE MAINTENANCE	
SAULT STE MARIE, MI	
SPRUCE ST-EXPANSION JOINT DETAILS	

COPYRIGHT 2023 OHM ADVISORS. ALL DRAWINGS AND WRITTEN MATERIALS APPEARING HEREIN CONSTITUTE THE ORIGINAL AND UNPUBLISHED WORK OF OHM ADVISORS AND THE SAME MAY NOT BE DUPLICATED, DISTRIBUTED, OR DISCLOSED WITHOUT PRIOR WRITTEN CONSENT OF OHM ADVISORS.



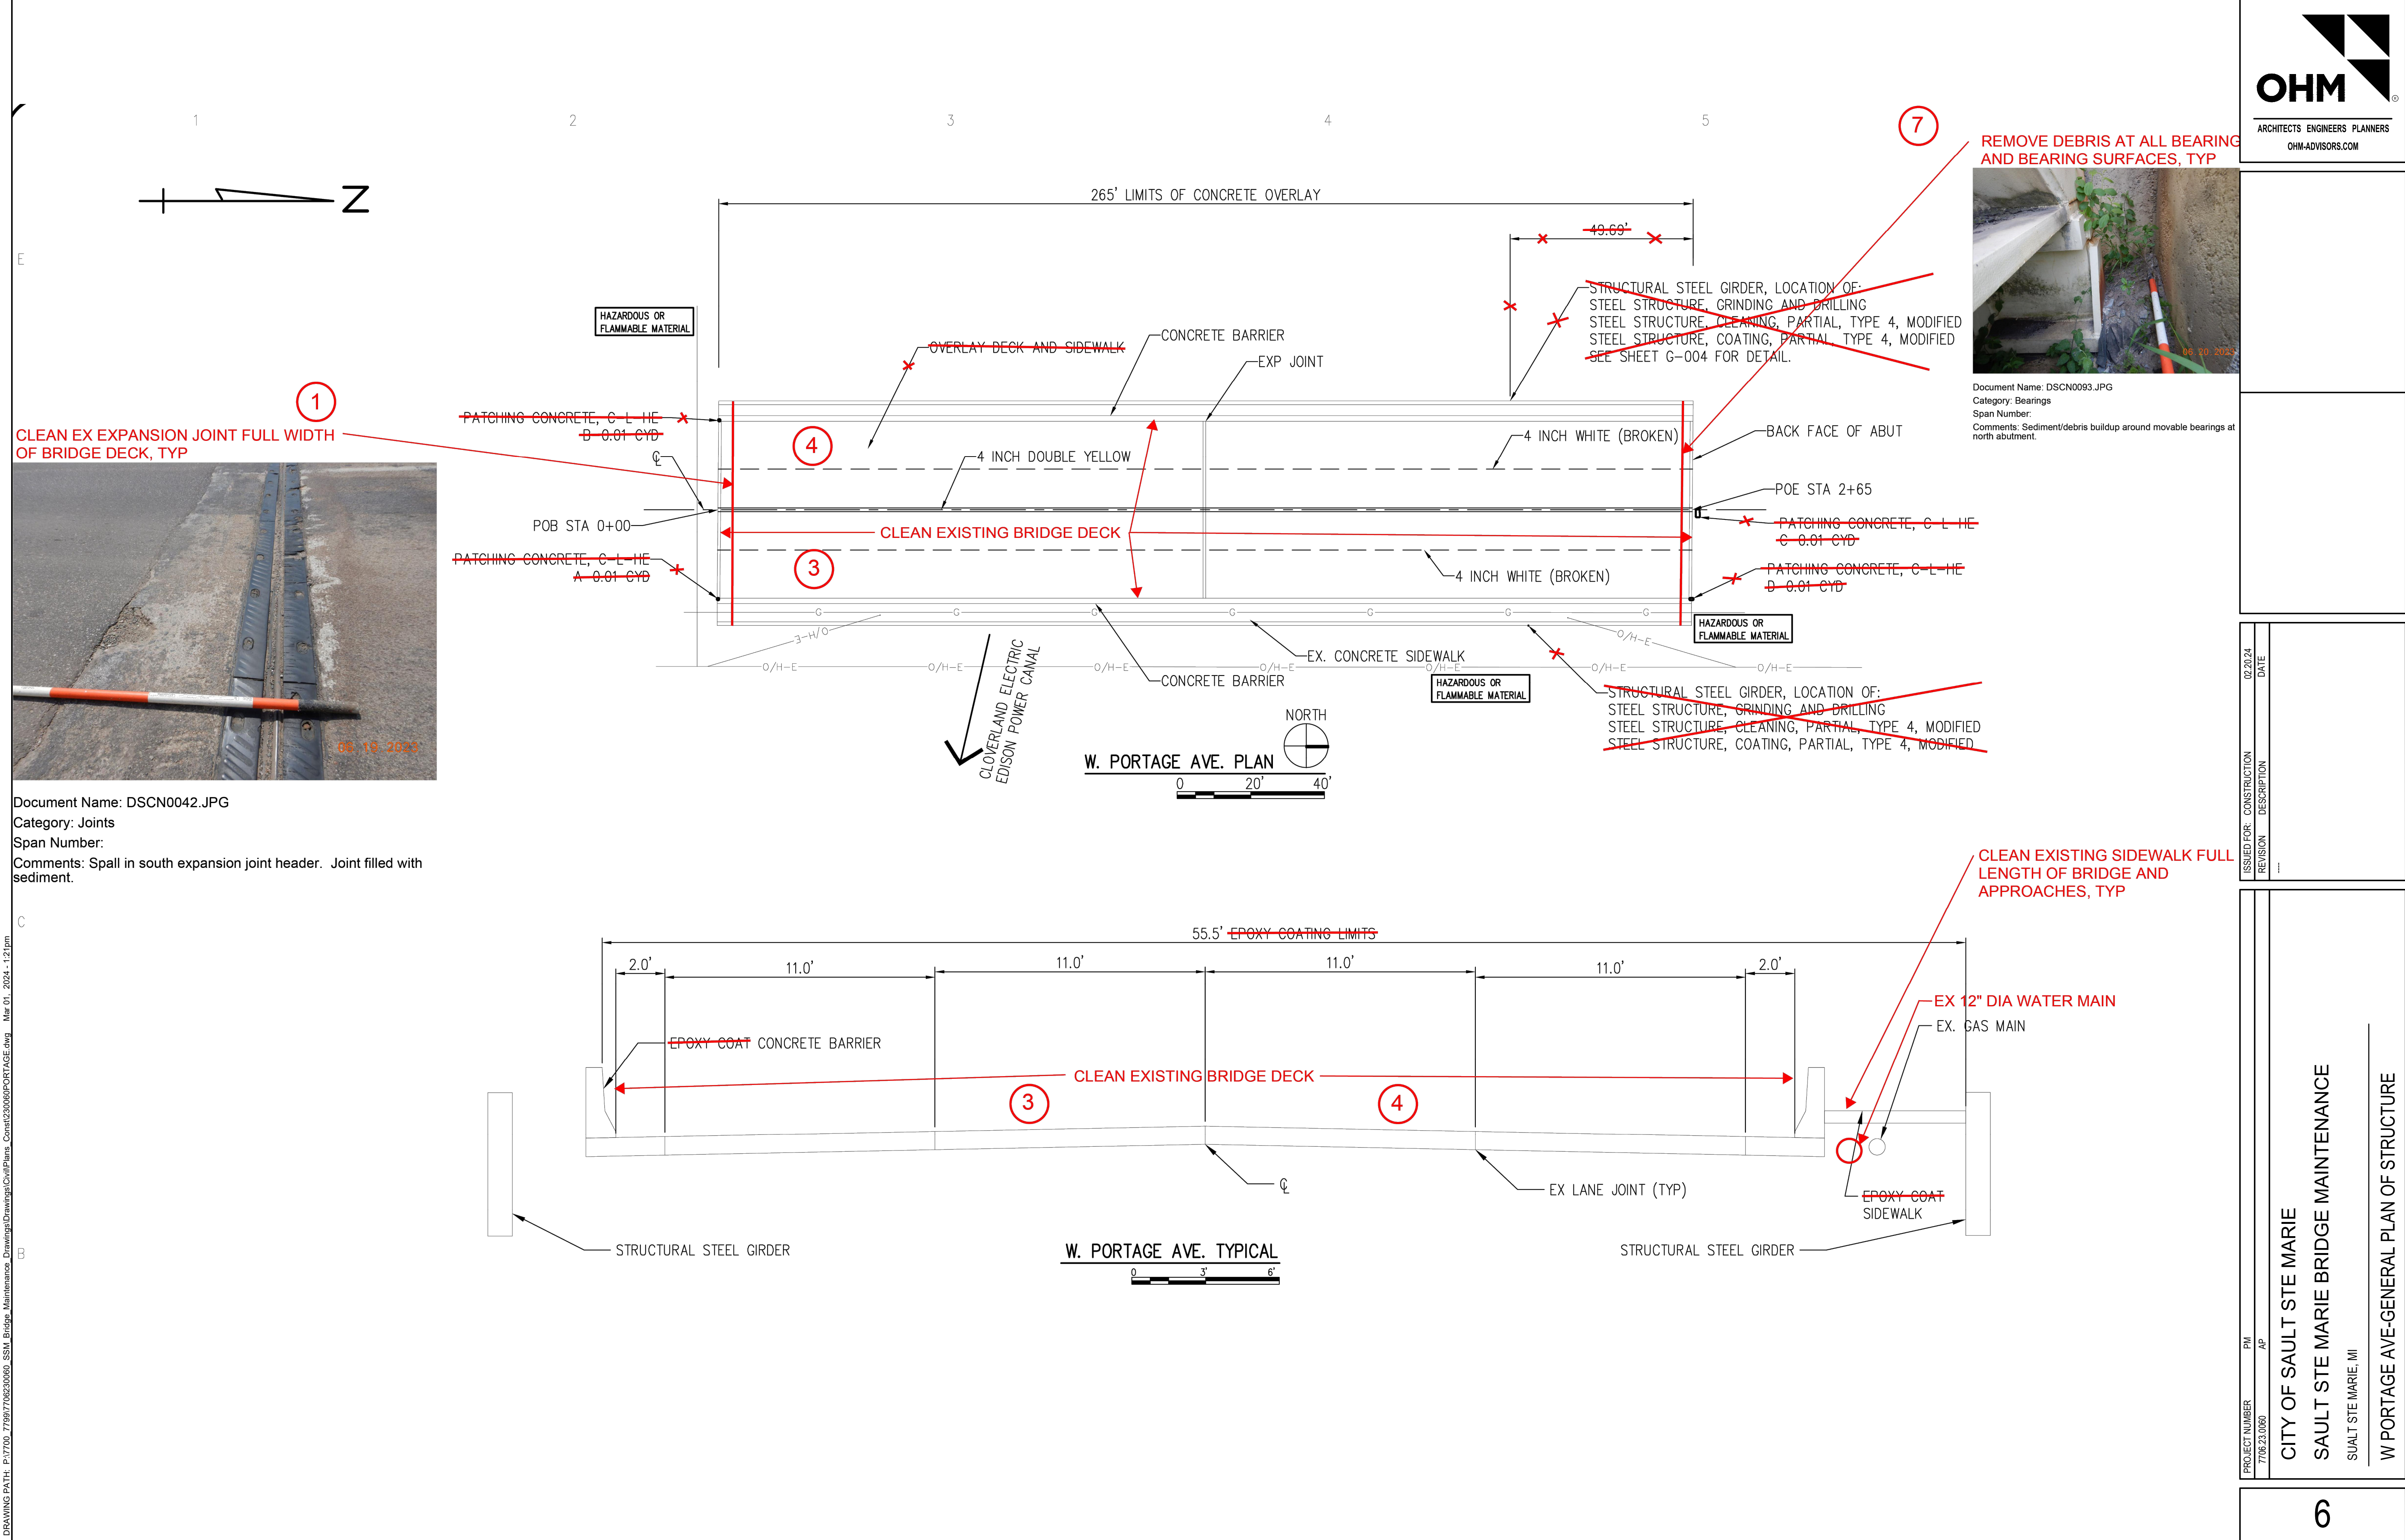

DRAWING PATH: P:\7700\_7799\770623060\_SSM\_Bridge\_Maintenance\_Drawings\Drawings\Civil\Plans\_Const\23060PORTAGE.dwg Mar 01, 2024 - 12:1pm



ARCHITECTS ENGINEERS PLANNERS  
OHM-ADVISORS.COM

PROJECT NUMBER	770623060
DATE	02/20/24
ISSUED FOR:	CONSTRUCTION
REVISION	DESCRIPTION
...	...

CITY OF SAULT STE MARIE

SAULT STE MARIE BRIDGE MAINTENANCE





SAULT STE MARIE, MI

W PORTAGE AVE-GENERAL PLAN OF STRUCTURE

6



DRAWING PATH: P:\7700 7799\770623060 SSM Bridge Maintenance Drawings\Civil\Plans Const\230606PORTAGE.dwg Mar 01, 2024 - 12:1pm

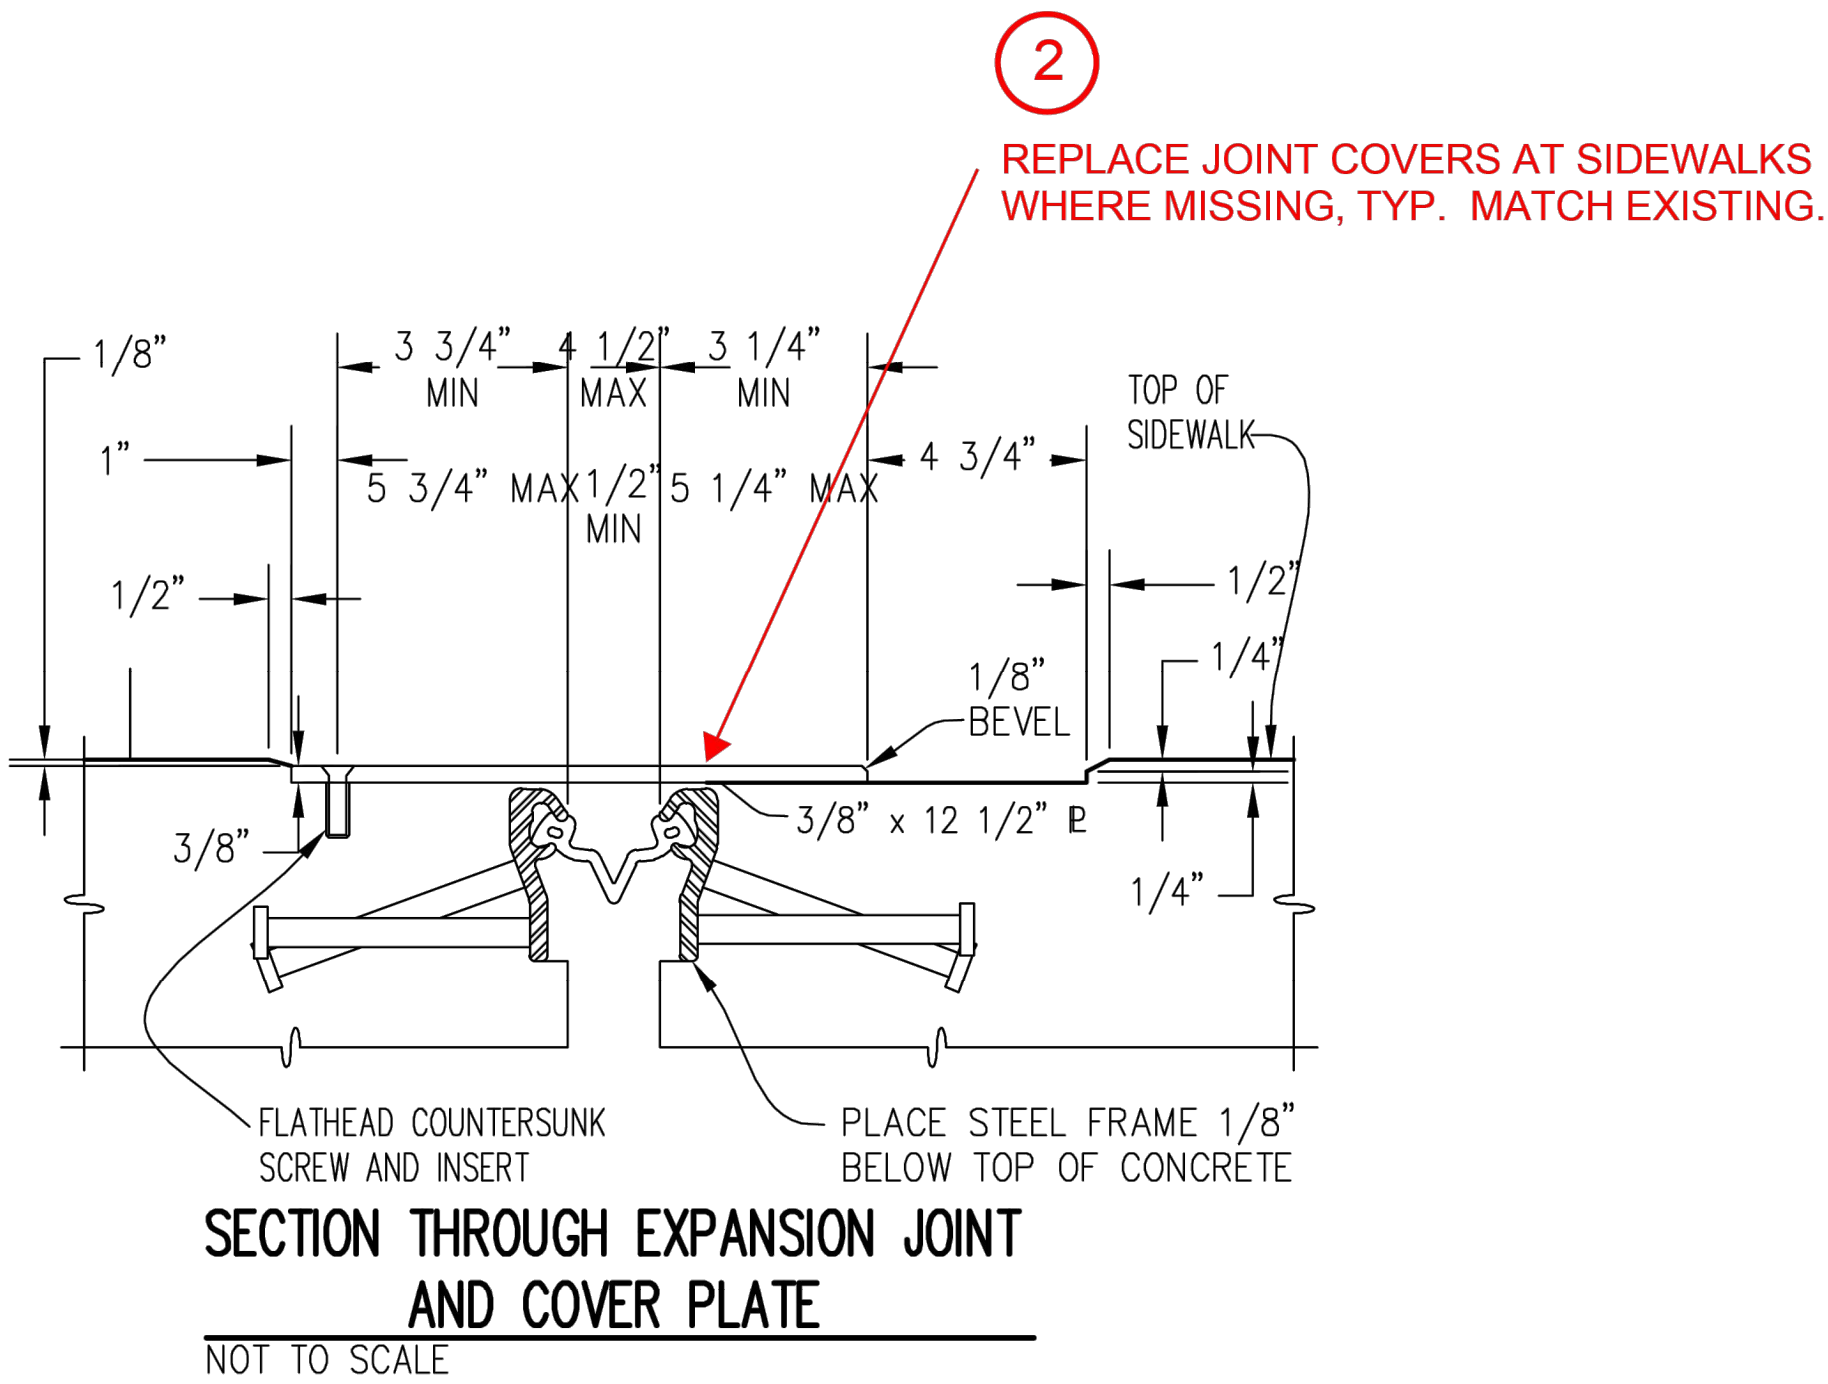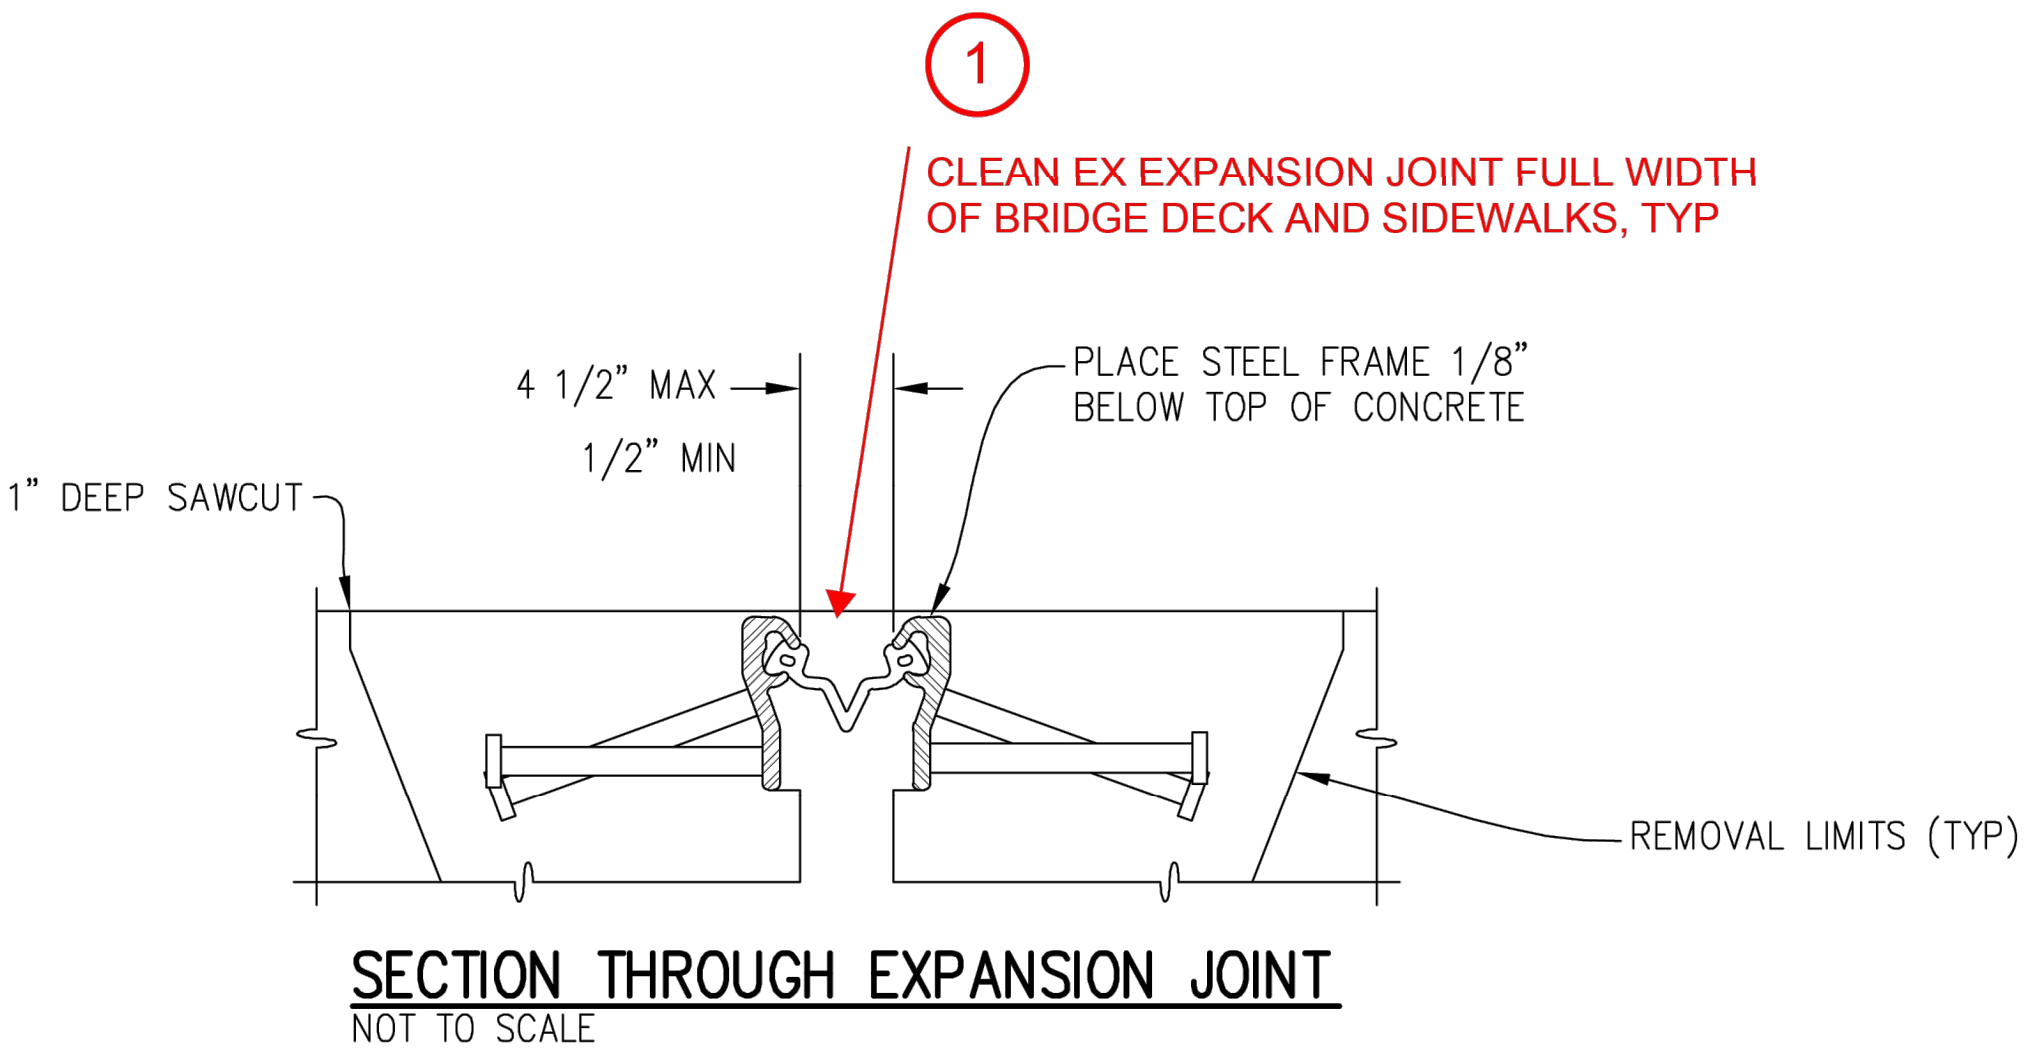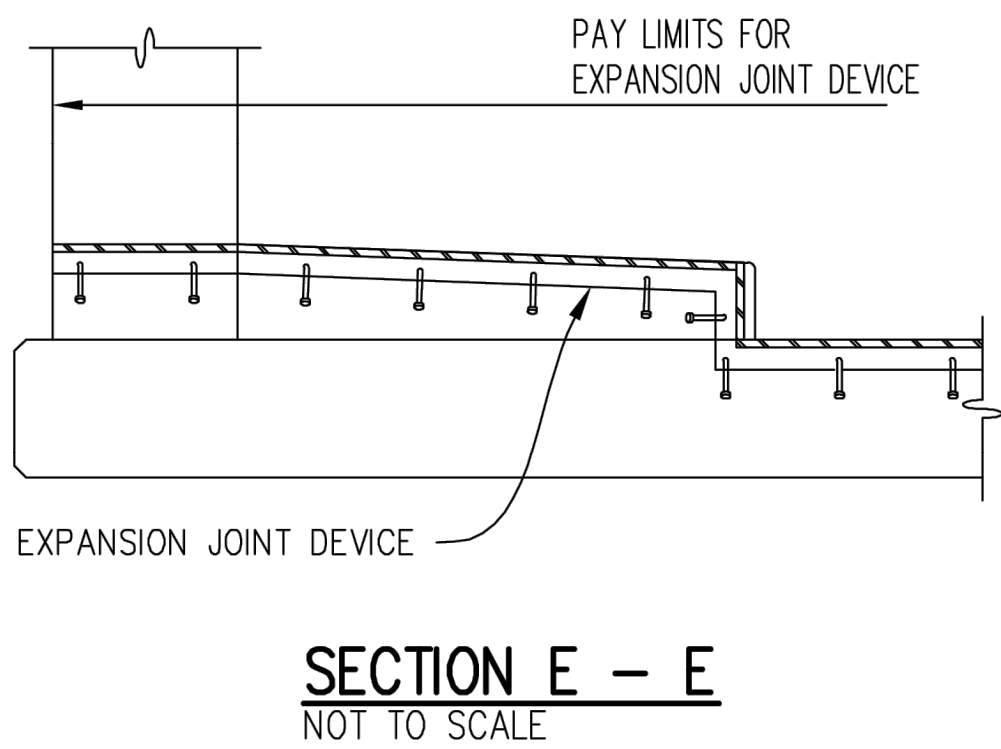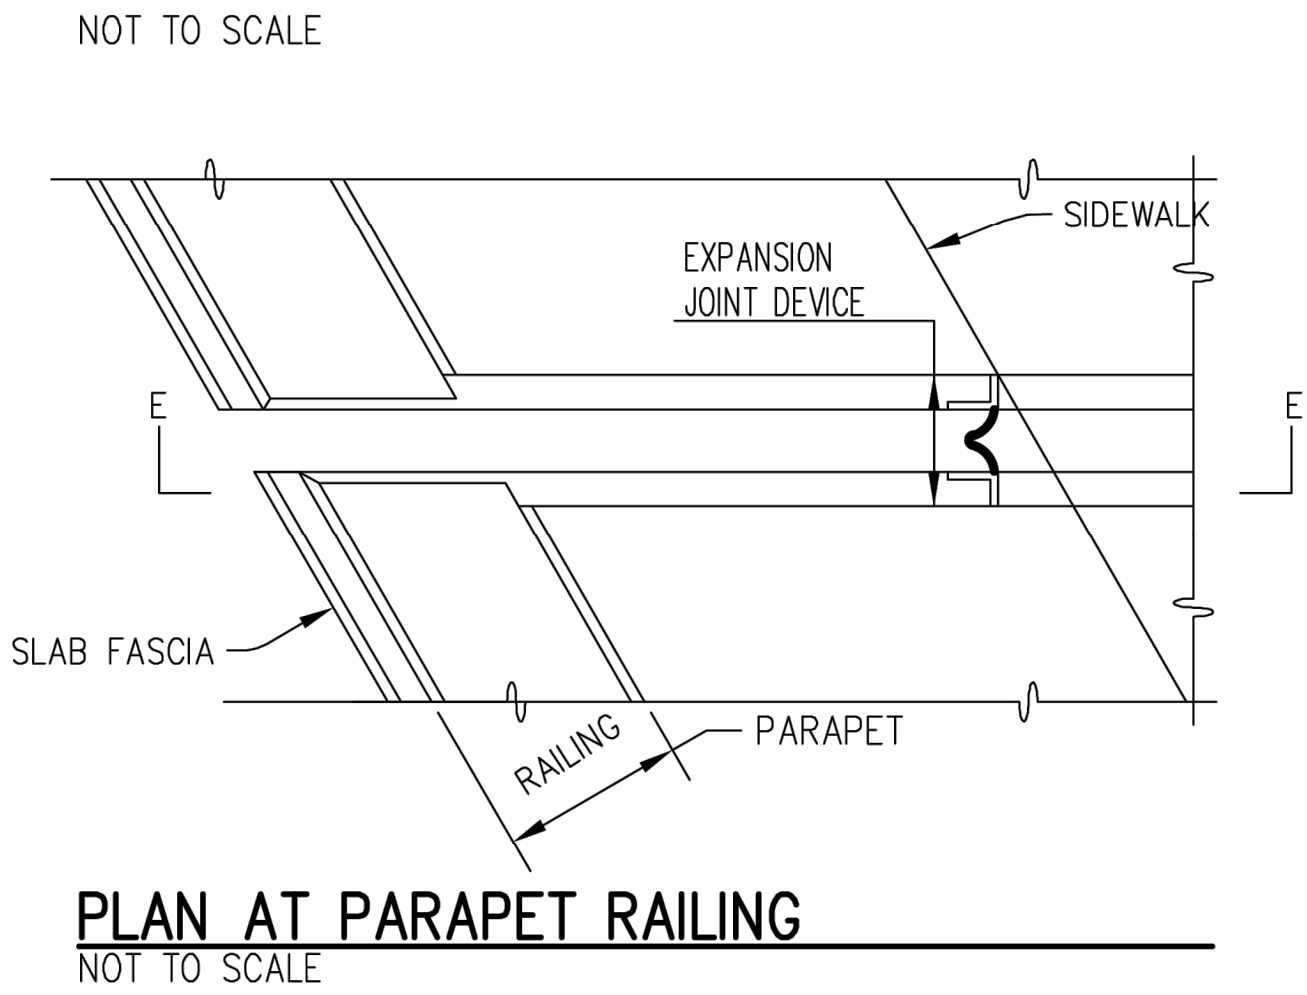



ISSUED FOR:	CONSTRUCTION	02/20/24
REVISION	DESCRIPTION	DATE
...		

PROJECT NUMBER	PM
770623.0060	AP
CITY OF SAULT STE MARIE	
SAULT STE MARIE BRIDGE MAINTENANCE	
SAULT STE MARIE, MI	
W PORTAGE AVE-EXPANSION JOINT DETAILS	

COPYRIGHT 2023 OHM ADVISORS. ALL DRAWINGS AND WRITTEN MATERIALS APPEARING HEREIN CONSTITUTE THE ORIGINAL AND UNPUBLISHED WORK OF OHM ADVISORS AND THE SAME MAY NOT BE DUPLICATED, DISTRIBUTED, OR DISCLOSED WITHOUT PRIOR WRITTEN CONSENT OF OHM ADVISORS.




DRAWING PATH: P:\7700 7799\770623060 SSM Bridge Maintenance Drawings\Civil\Plans Const\23060RIVERSIDE.dwg Mar 01, 2024 - 12 pm

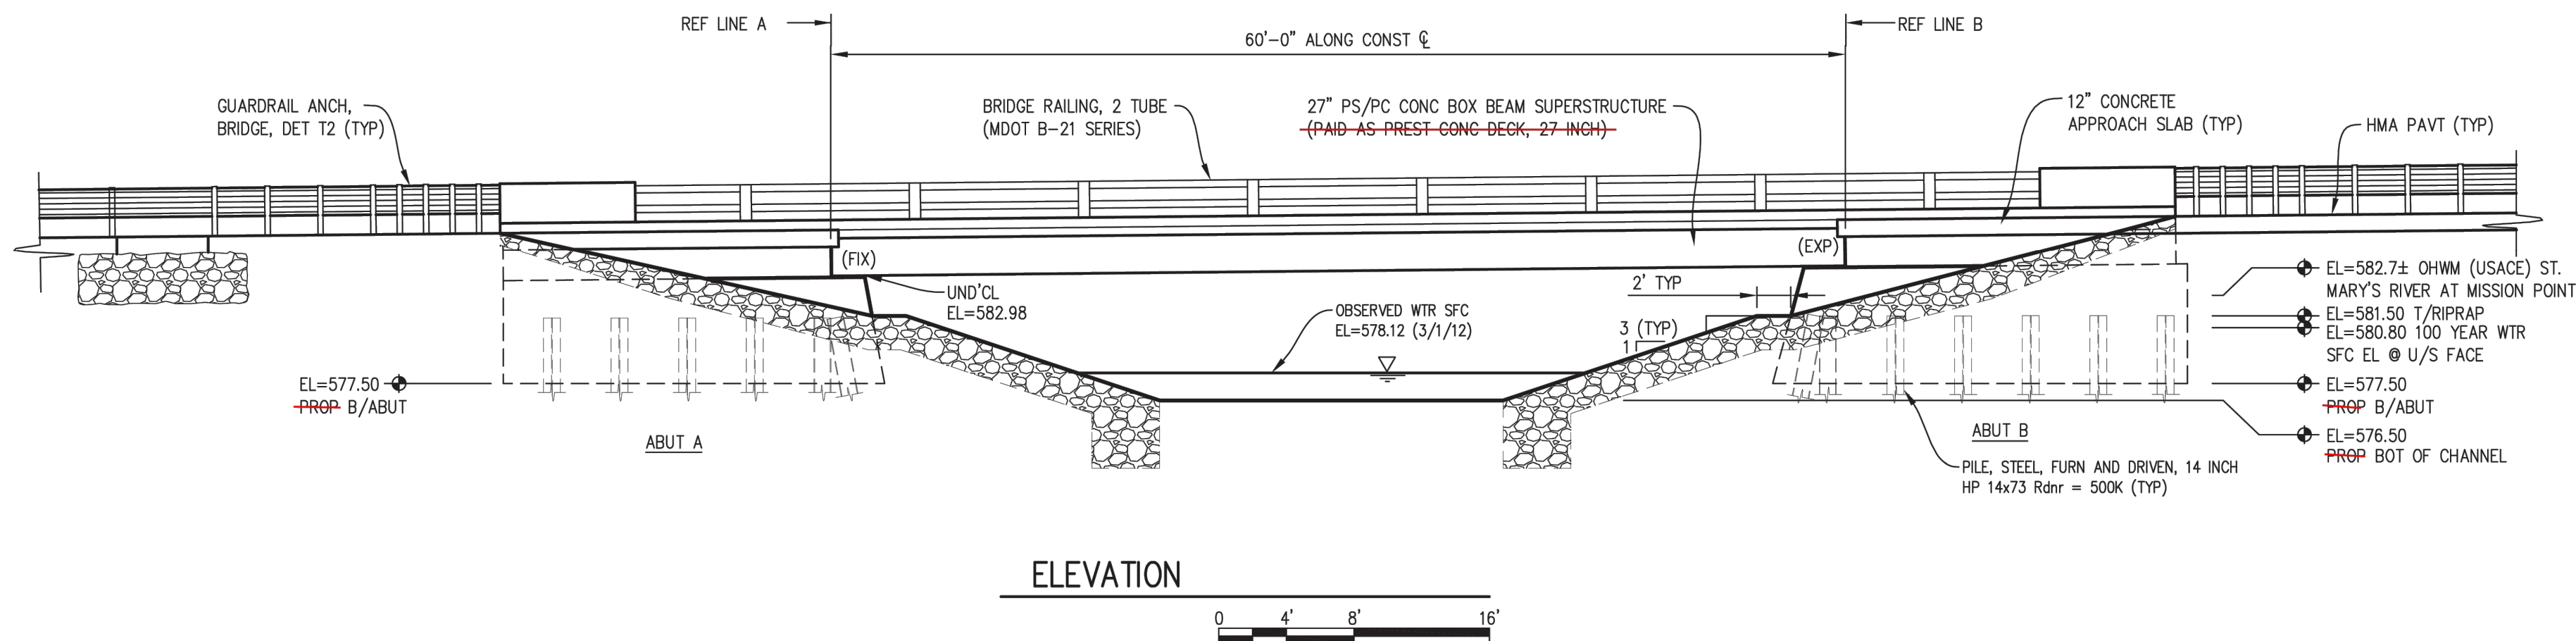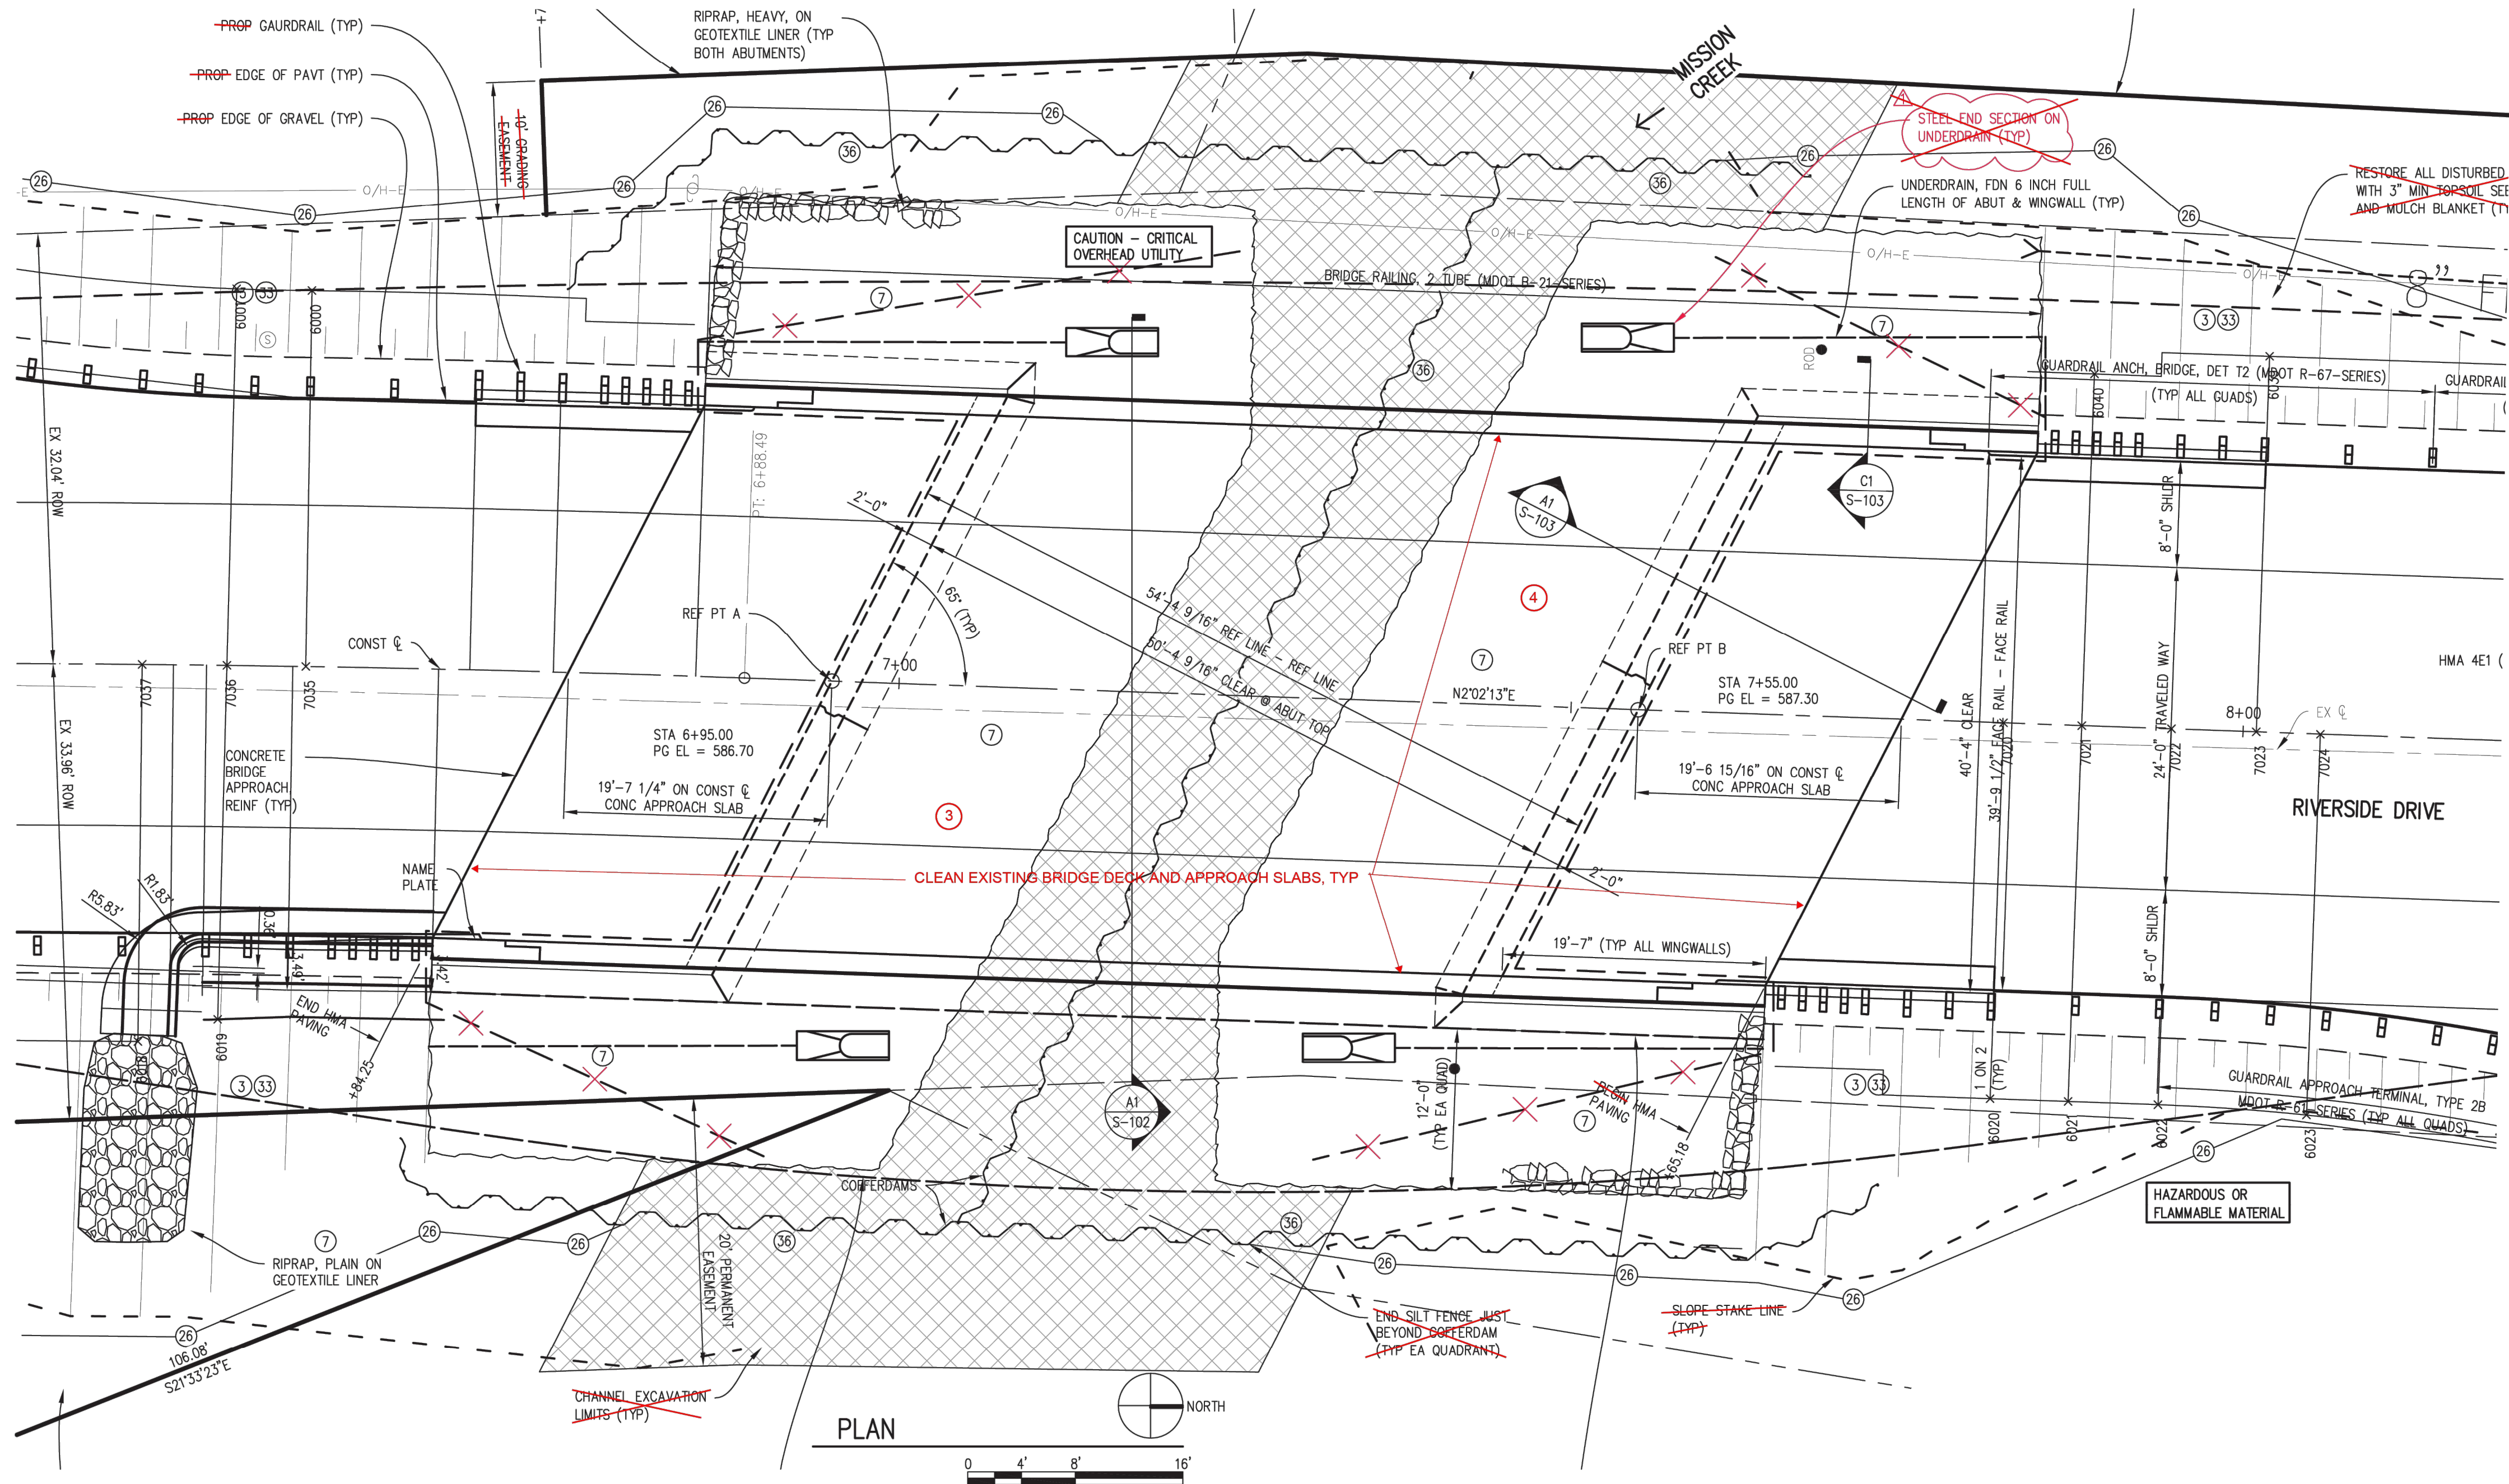




DRAWING PATH: P:\7700 7799\770623060 SSM Bridge Maintenance Drawings\Civil\Plans Const\23060RIVERSIDE.dwg Mar 01, 2024 - 1:22pm

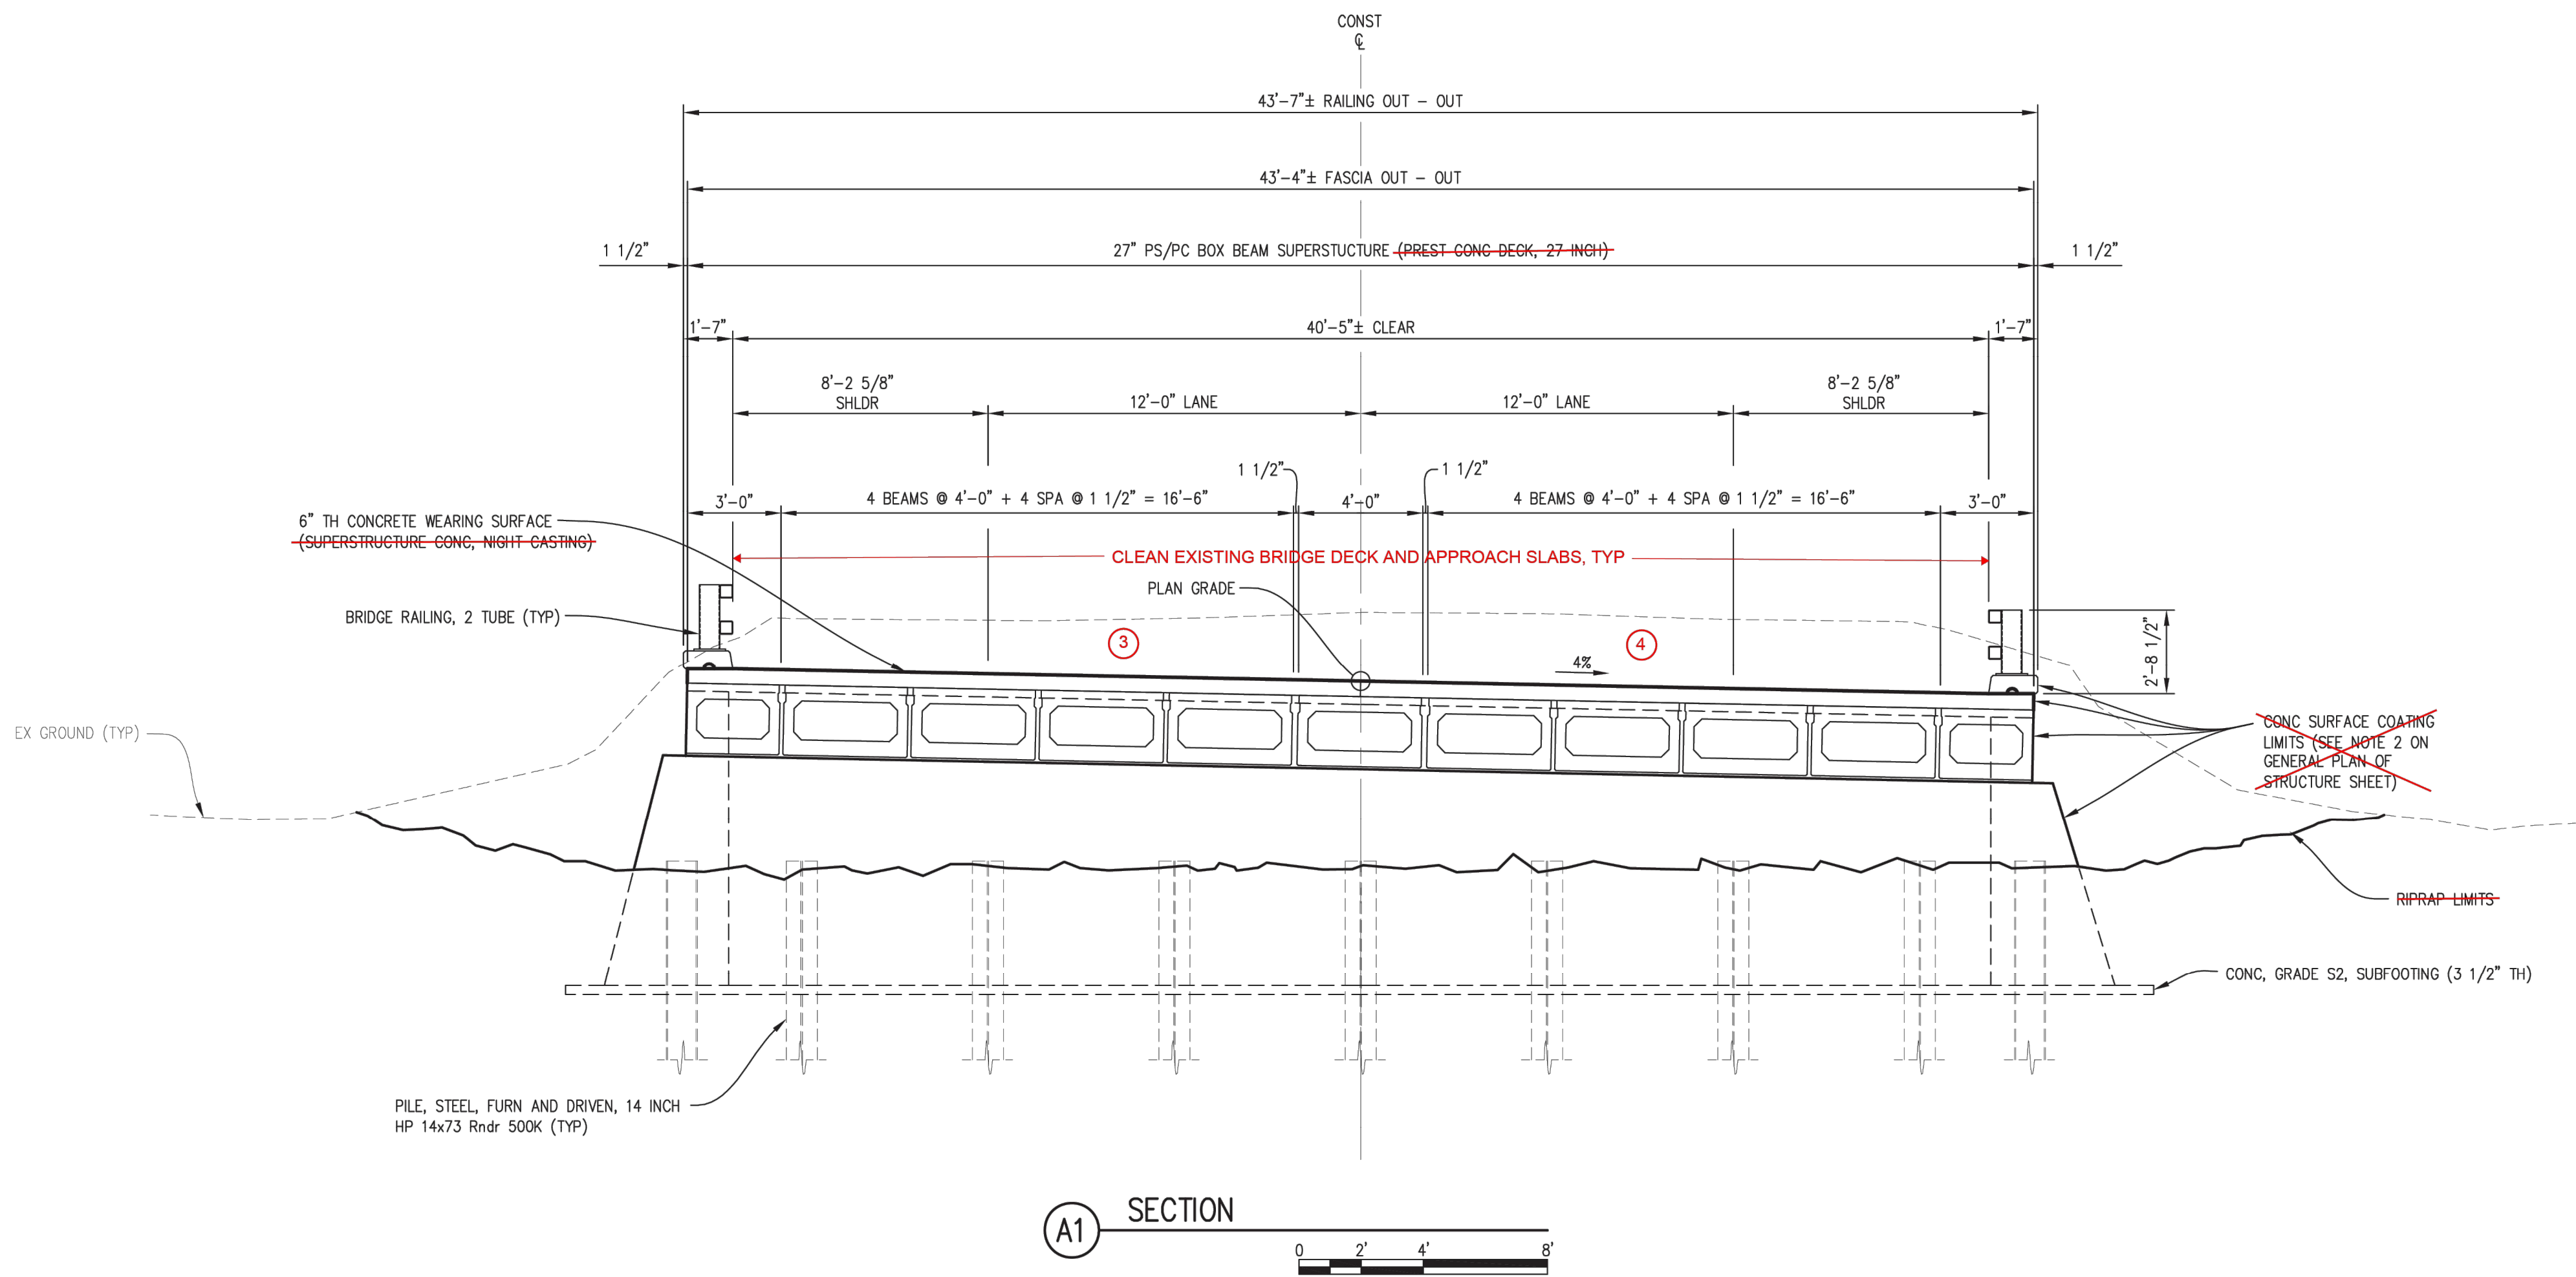









DRAWING PATH: P:\7700 7799\7702\3060 SSM Bridge Maintenance Drawings\Civil\Plans Const\230608\BINGHAM.dwg Mar 01, 2024 - 1:25pm

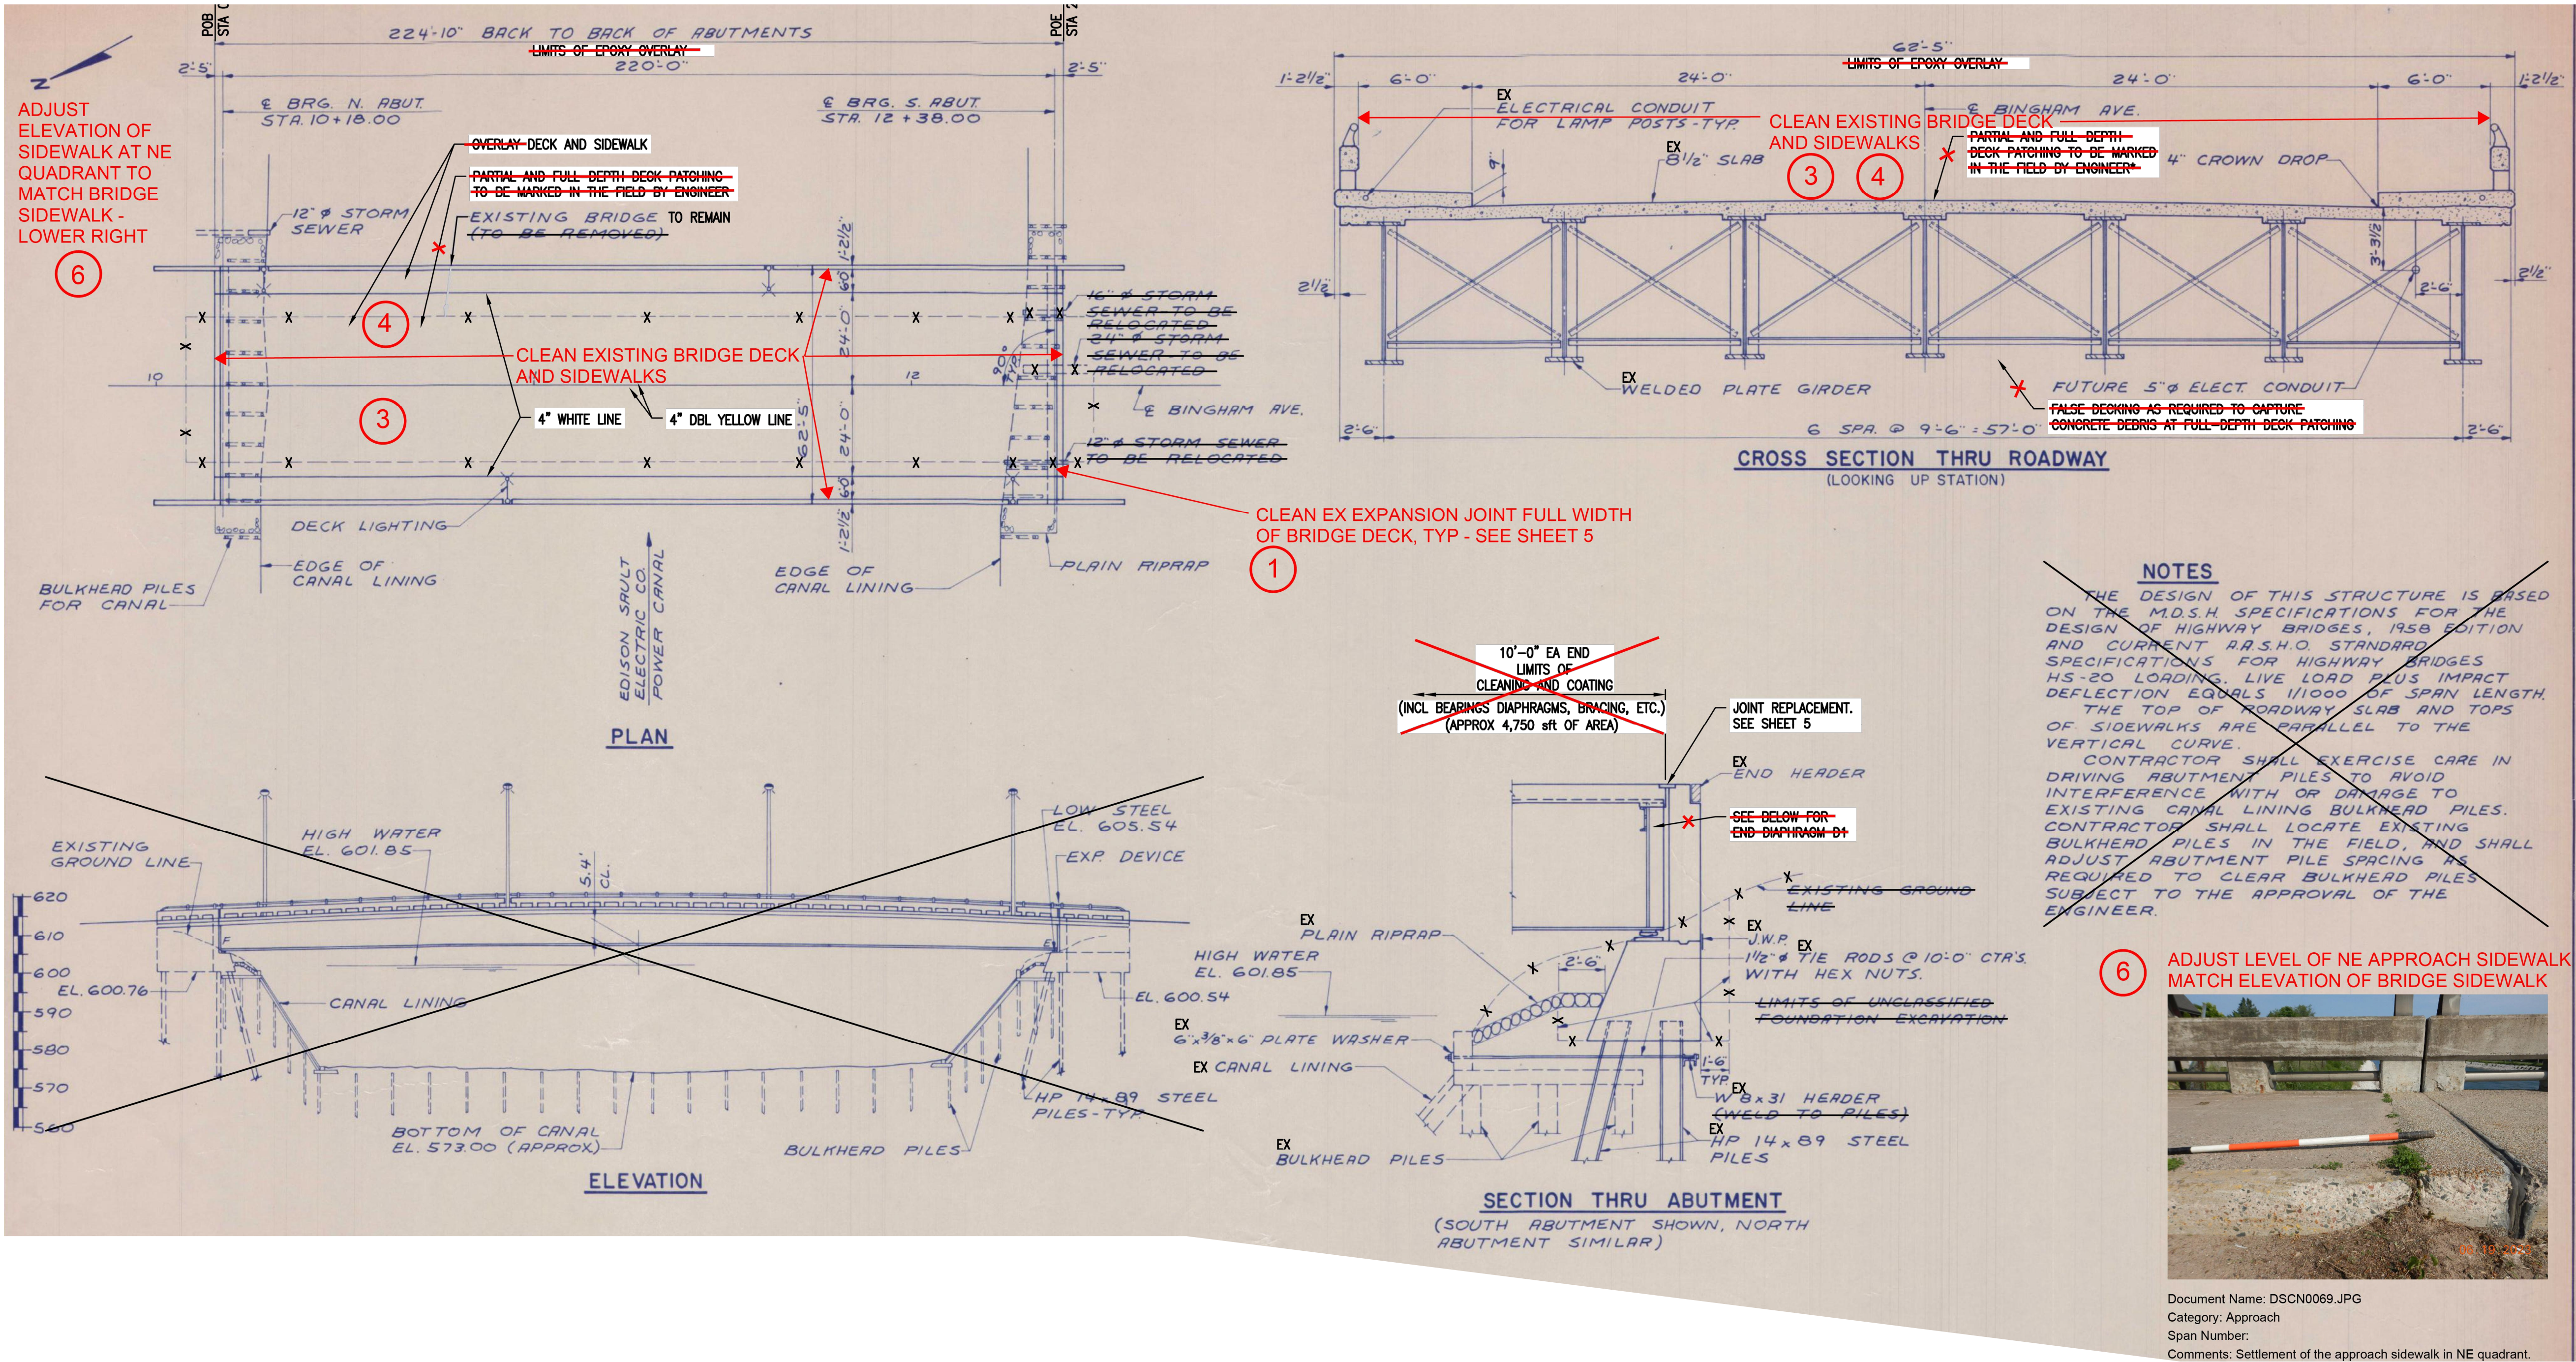

ISSUED FOR:	CONSTRUCTION	02.20.24
REVISION	DESCRIPTION	DATE

PROJECT NUMBER	PM	AP
7702.23.0060		



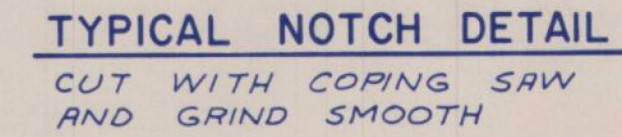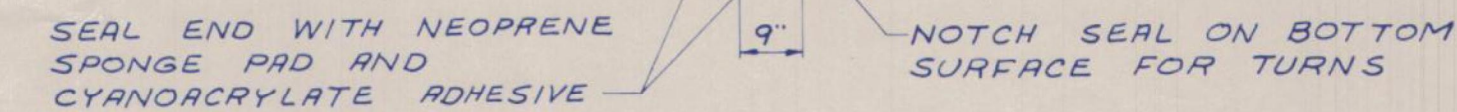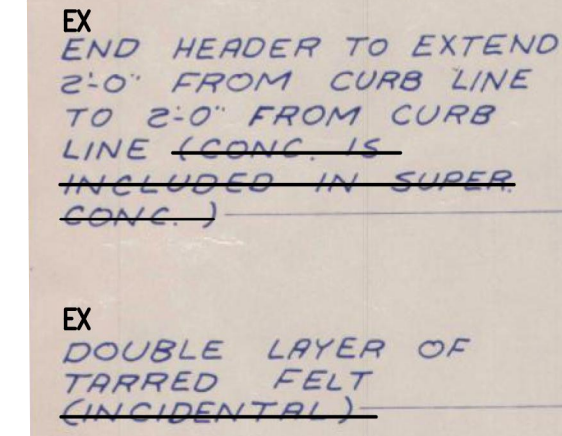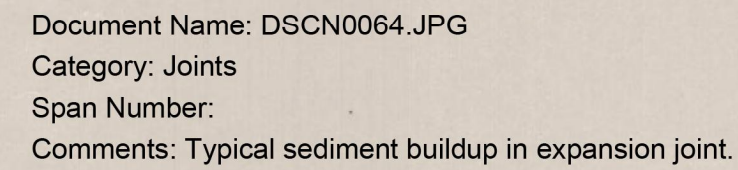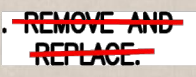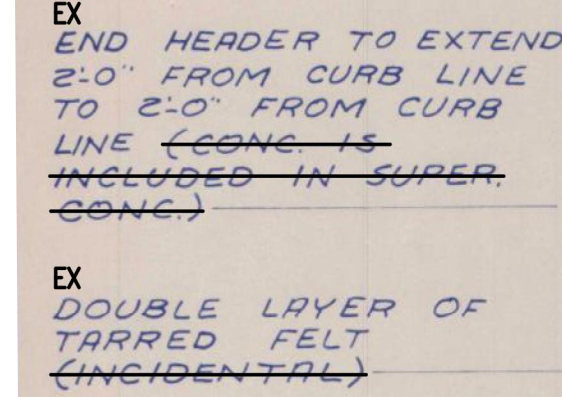


ISSUED FOR:	CONSTRUCTION	02.20.24
REVISION	DESCRIPTION	DATE

PROJECT NUMBER	PM
7706.23.0060	AP



DRAWING PATH: P:\7700 7799\770623060 SSM Bridge Maintenance Drawings\Civil\Plans Const\230606JOHNSTONE.dwg Mar 01, 2024 - 1:22pm

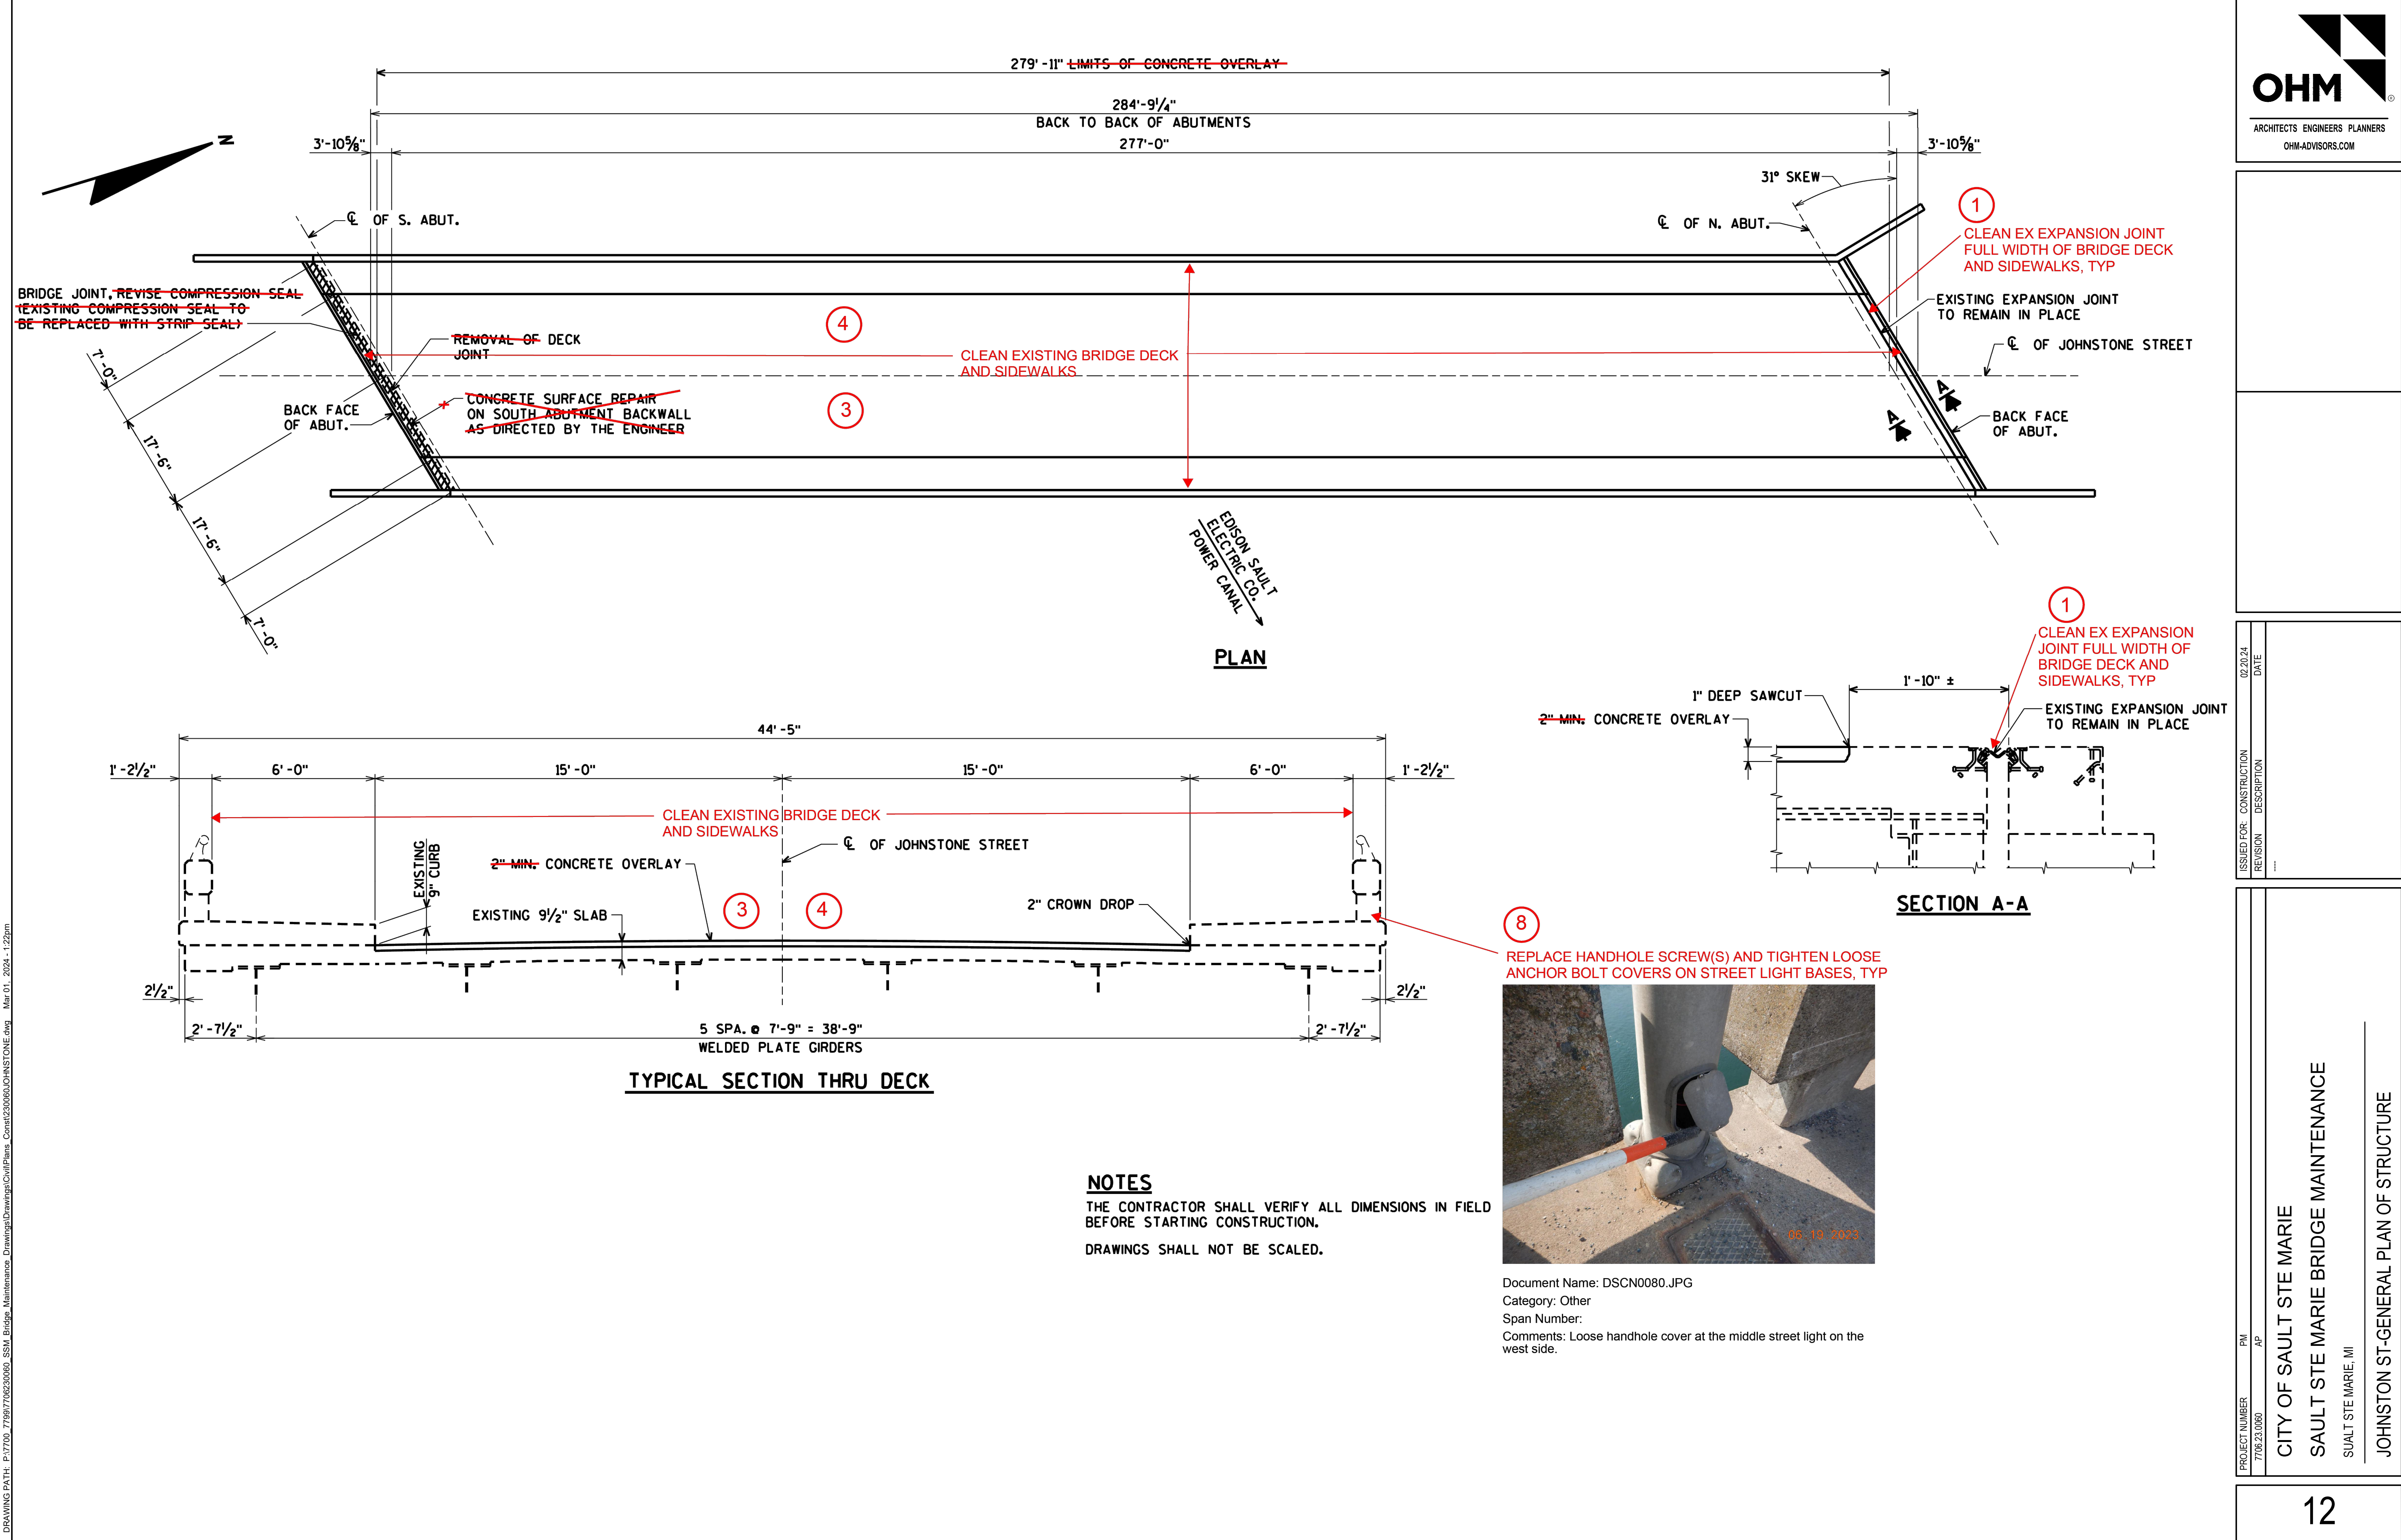

OHM  
ARCHITECTS ENGINEERS PLANNERS  
OHM-ADVISORS.COM

ISSUED FOR:	CONSTRUCTION	DATE	02/20/24
REVISION	DESCRIPTION		

PROJECT NUMBER  
770623060

PM  
AP


CITY OF SAULT MARIE  
SAULT STE MARIE BRIDGE MAINTENANCE  
SAULT STE MARIE, MI

JOHNSTON ST-GENERAL PLAN OF STRUCTURE


12



DRAWING PATH: P:\7700 7799\770623060 SSM Bridge Maintenance Drawings\Civil\Plans Const\23060JOHNSTONE.dwg Mar 01, 2024 - 1:22pm

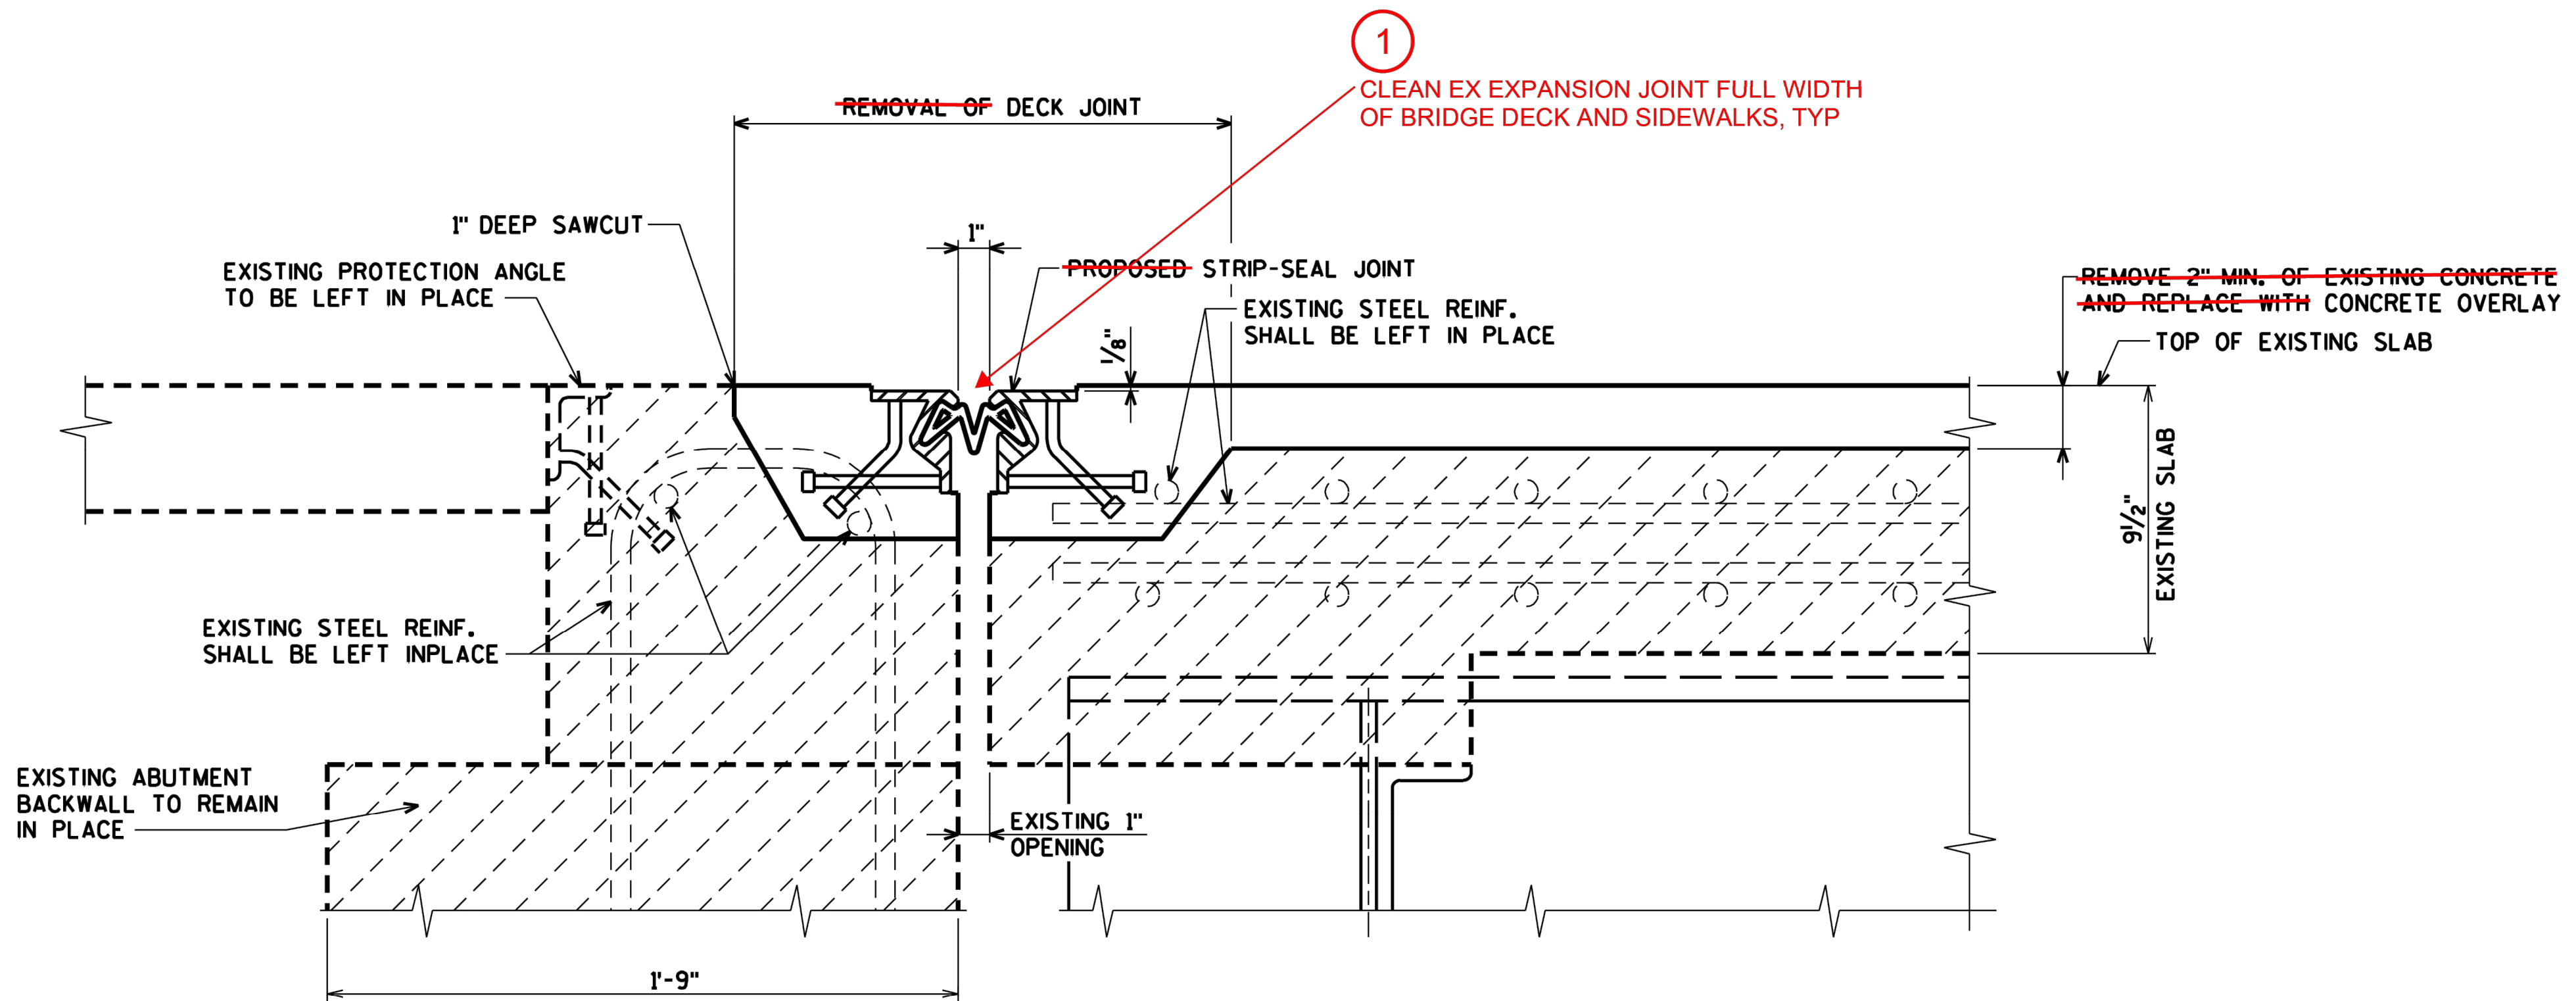

SECTION THRU JOINT IN ROADWAY

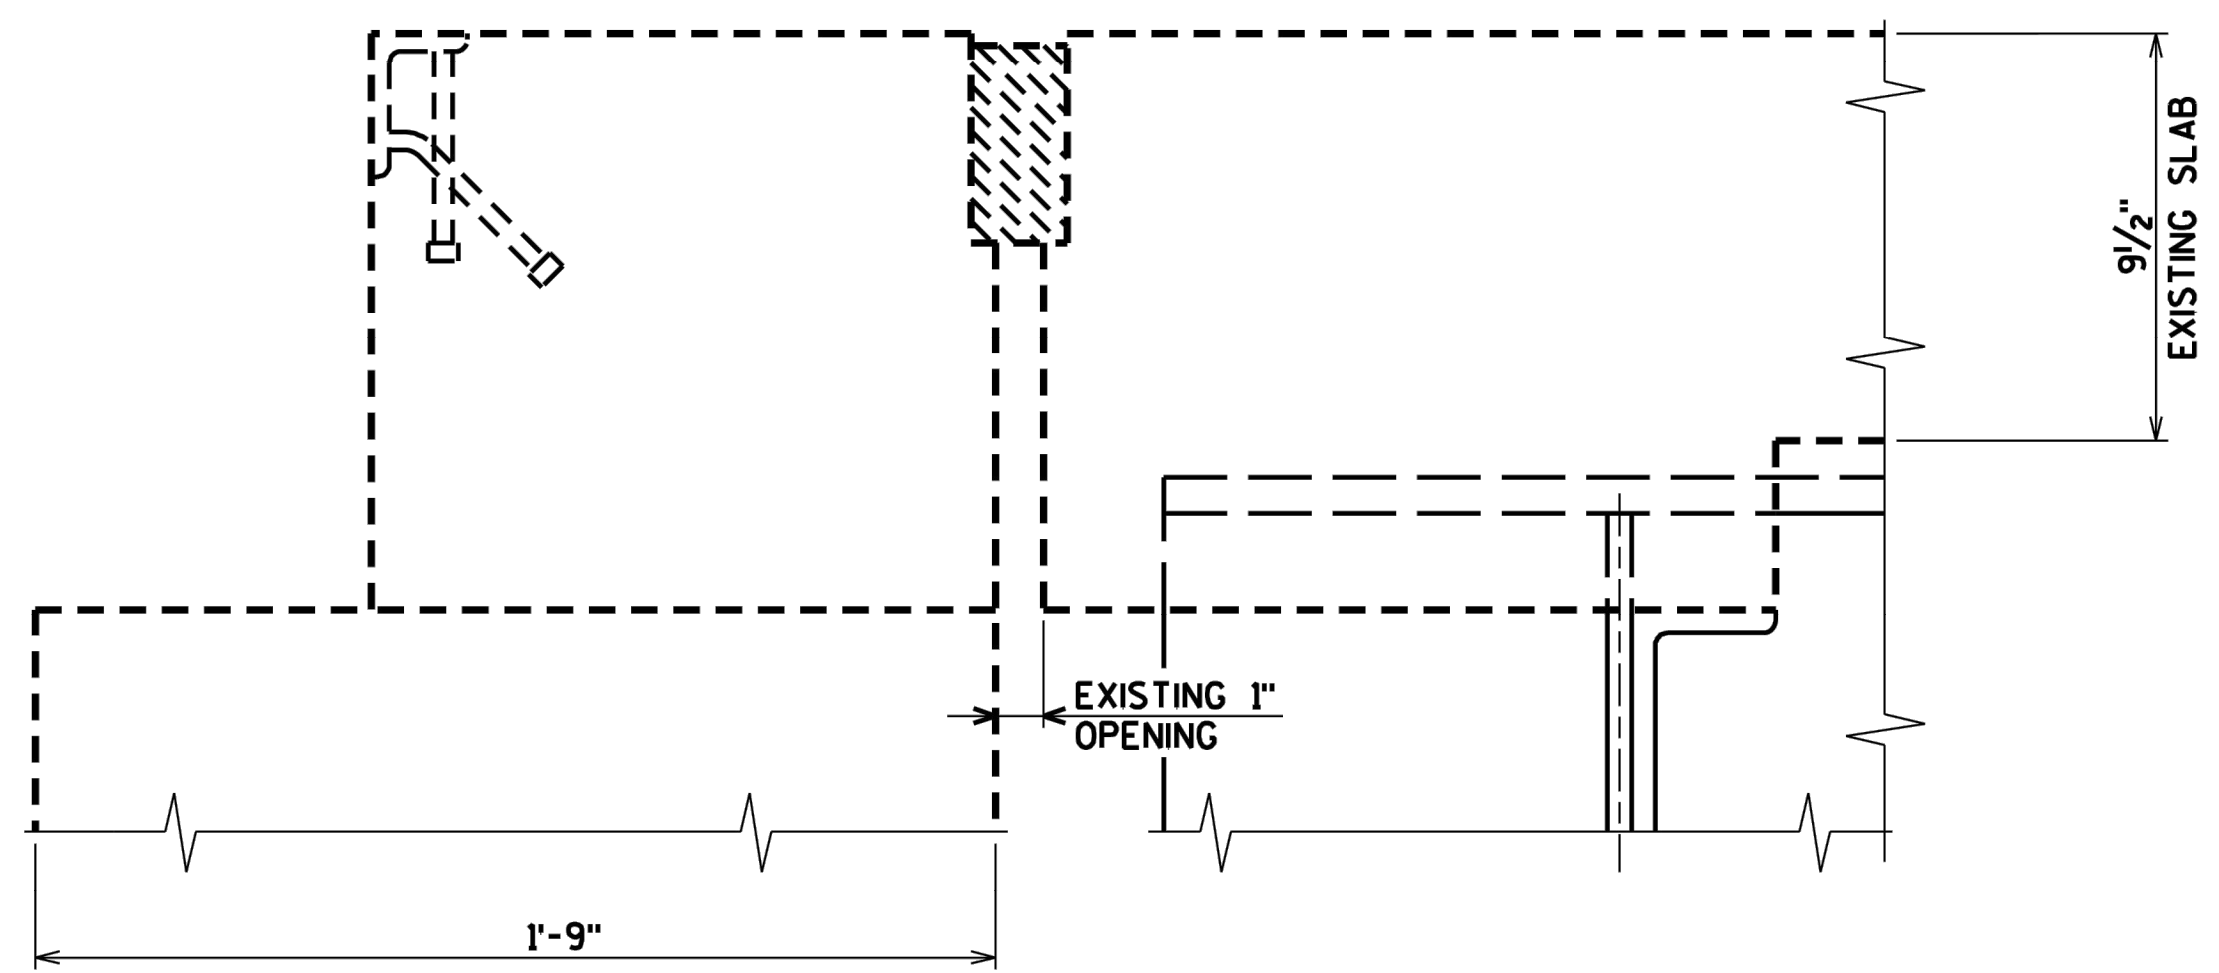

SECTION THRU EXISTING JOINT

SIDEWALK SECTIONS

ALL STEEL FOR EXPANSION JOINT AND COVER PLATE SHALL BE AASHTO M270, GRADE 36, AND GALVANIZED (ASTM A123) WITH A STATIC COEFFICIENT OF FRICTION OF 0.6 OR GREATER.

USE ASTM F 593 (TYPE 304) STAINLESS STEEL 3/4" DIAMETER FLATHEAD COUNTERSUNK SCREWS WITH 3/4" DIAMETER INSERTS.

~~CAST CURBS AND SIDEWALKS WITH 3/8" SLIDING PLATES IN PLACE TO INSURE THAT INSERTS AND SCREWS ARE ALIGNED PROPERLY. APPLY BOND BREAKER TO SLIDING PLATES PRIOR TO INSTALLATION.~~

~~FORM CONCRETE RECESS AREA IN SIDEWALK AND GRIND TO PROVIDE SMOOTH SURFACE. TOOL OR GRIND CONCRETE EDGES TO 1/4" RADIUS. APPLY ONE COAT OF EPOXY RESIN ADHESIVE TO ALLOW BENT SLIDING PLATE TO MOVE FREELY WITHOUT FRICTION. CARE SHALL BE TAKEN SO THAT NO ADHESIVE COMES IN CONTACT WITH ANY PART OF THE EXPANSION JOINT DEVICE OR GLAND. REMOVE ANY FOREIGN PARTICLES FROM THE SURFACE PRIOR TO INSTALLING PLATES.~~

INSTALL PLATES SO THAT THE SCREWS AND INSERTS ARE SET ON THE HIGH SIDE OF LONGITUDINAL SIDEWALK GRADE.


~~THE COSTS OF ALL MATERIALS AND LABOR REQUIRED FOR PROPER INSTALLATION OF THE COVER PLATE IS INCLUDED IN THE PAYMENT FOR "BRIDGE JOINT, REVISE COMPRESSION SEAL".~~

ISSUED FOR:	CONSTRUCTION	02/20/24
REVISION	DESCRIPTION	DATE

PROJECT NUMBER	PM	AP
770623060		
CITY OF SAULT STE MARIE		
SAULT STE MARIE BRIDGE MAINTENANCE		
SAULT STE MARIE, MI		
JOHNSTON ST-EXPANSION JOINT DETAILS		



DRAWING PATH: P:\7700 7799\770623060 SSM Bridge Maintenance Drawings\Civil\Plans Const\230606JOHNSTONE.dwg    Mar 01, 2024 - 1:23pm

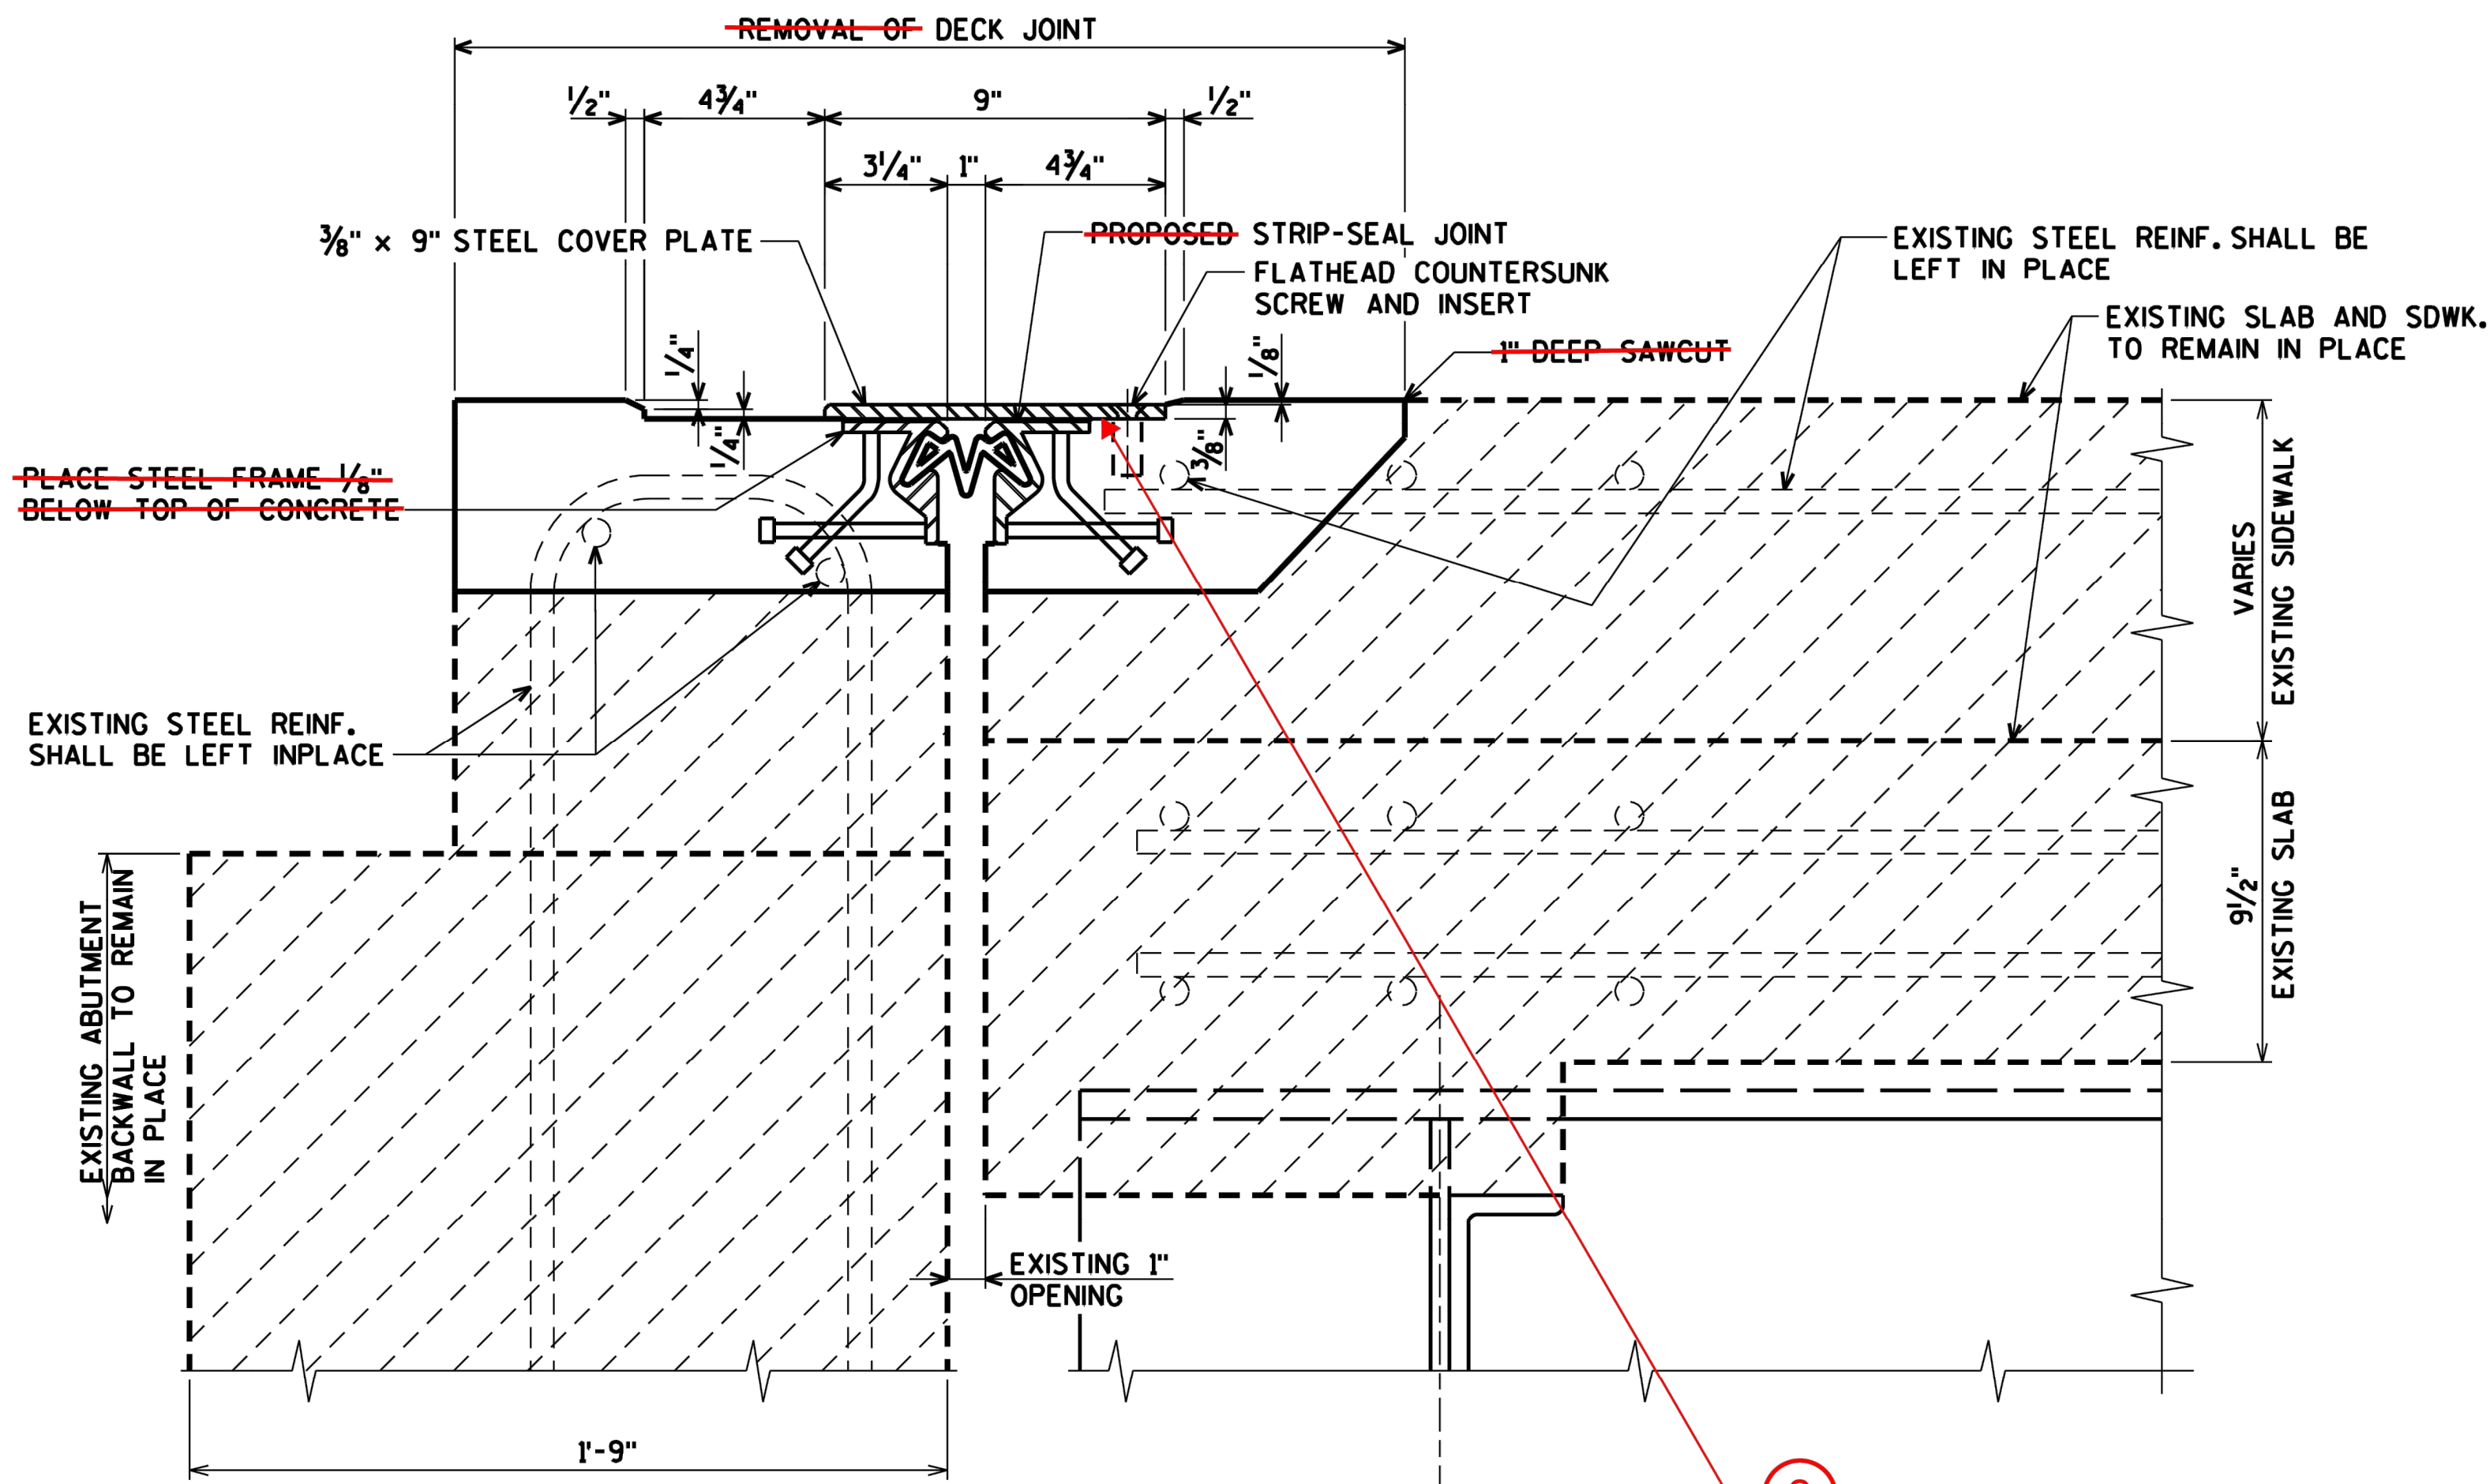


SECTION THRU JOINT IN SIDEWALK


2  
REPLACE JOINT COVERS AT SIDEWALKS  
WHERE MISSING, TYP. MATCH EXISTING.



Document Name: DSCN0081.JPG  
Category: Joints  
Span Number:  
Comments: Missing cover plate on the east and west sidewalk at the north expansion joint. Also, showing damage to the expansion joint at face of curb.

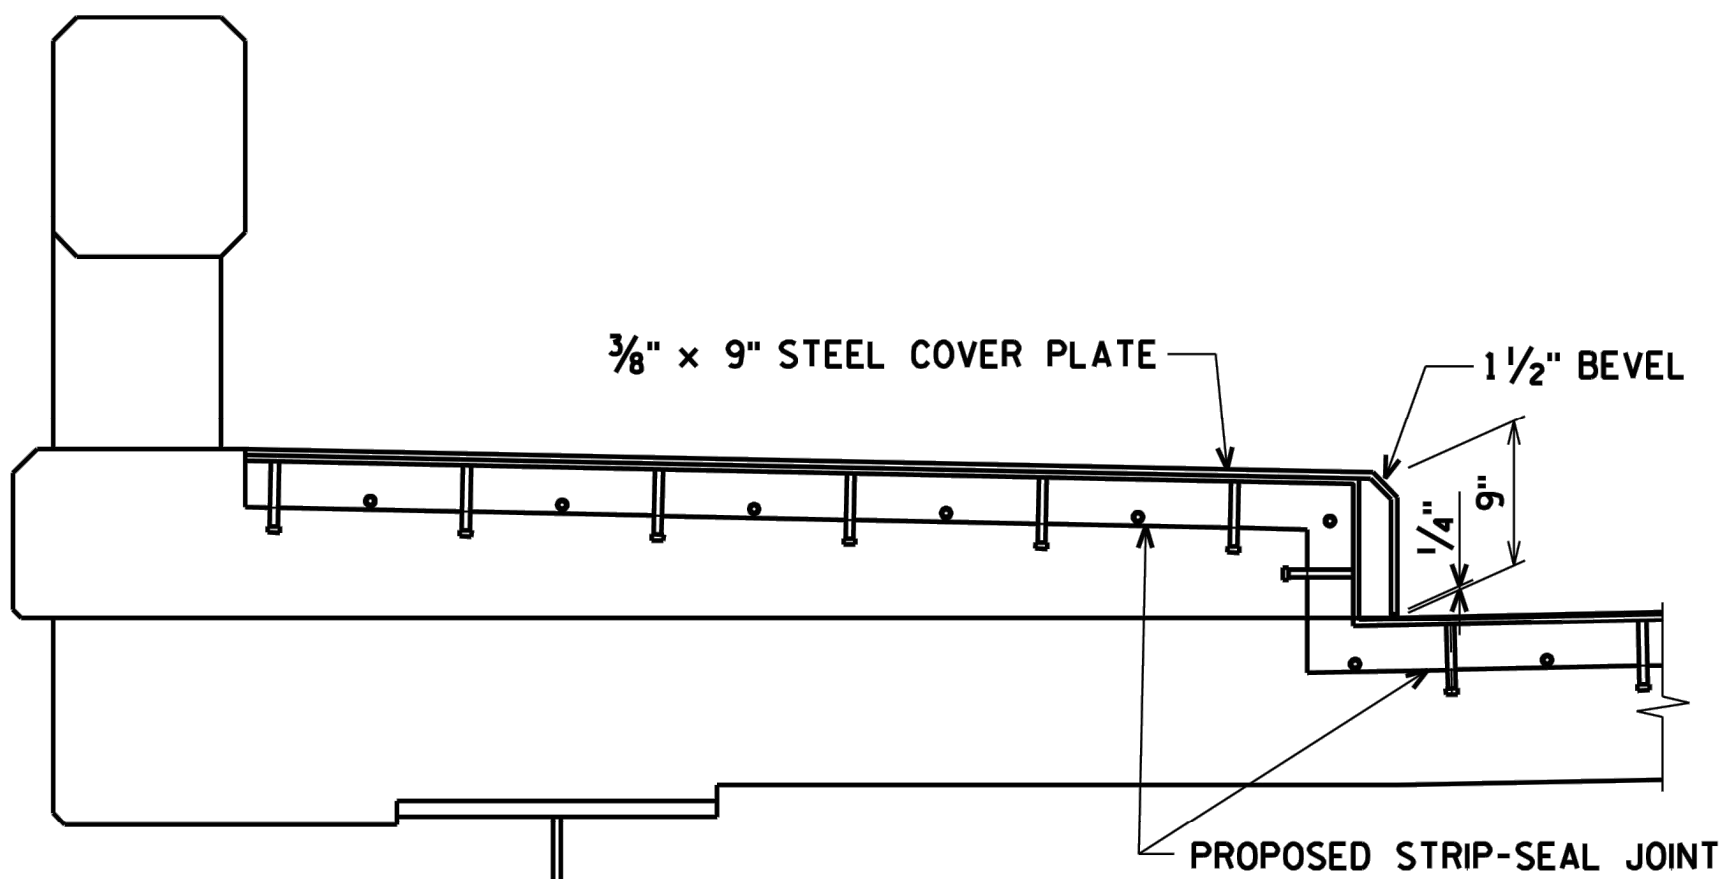

SECTION THRU SIDEWALK

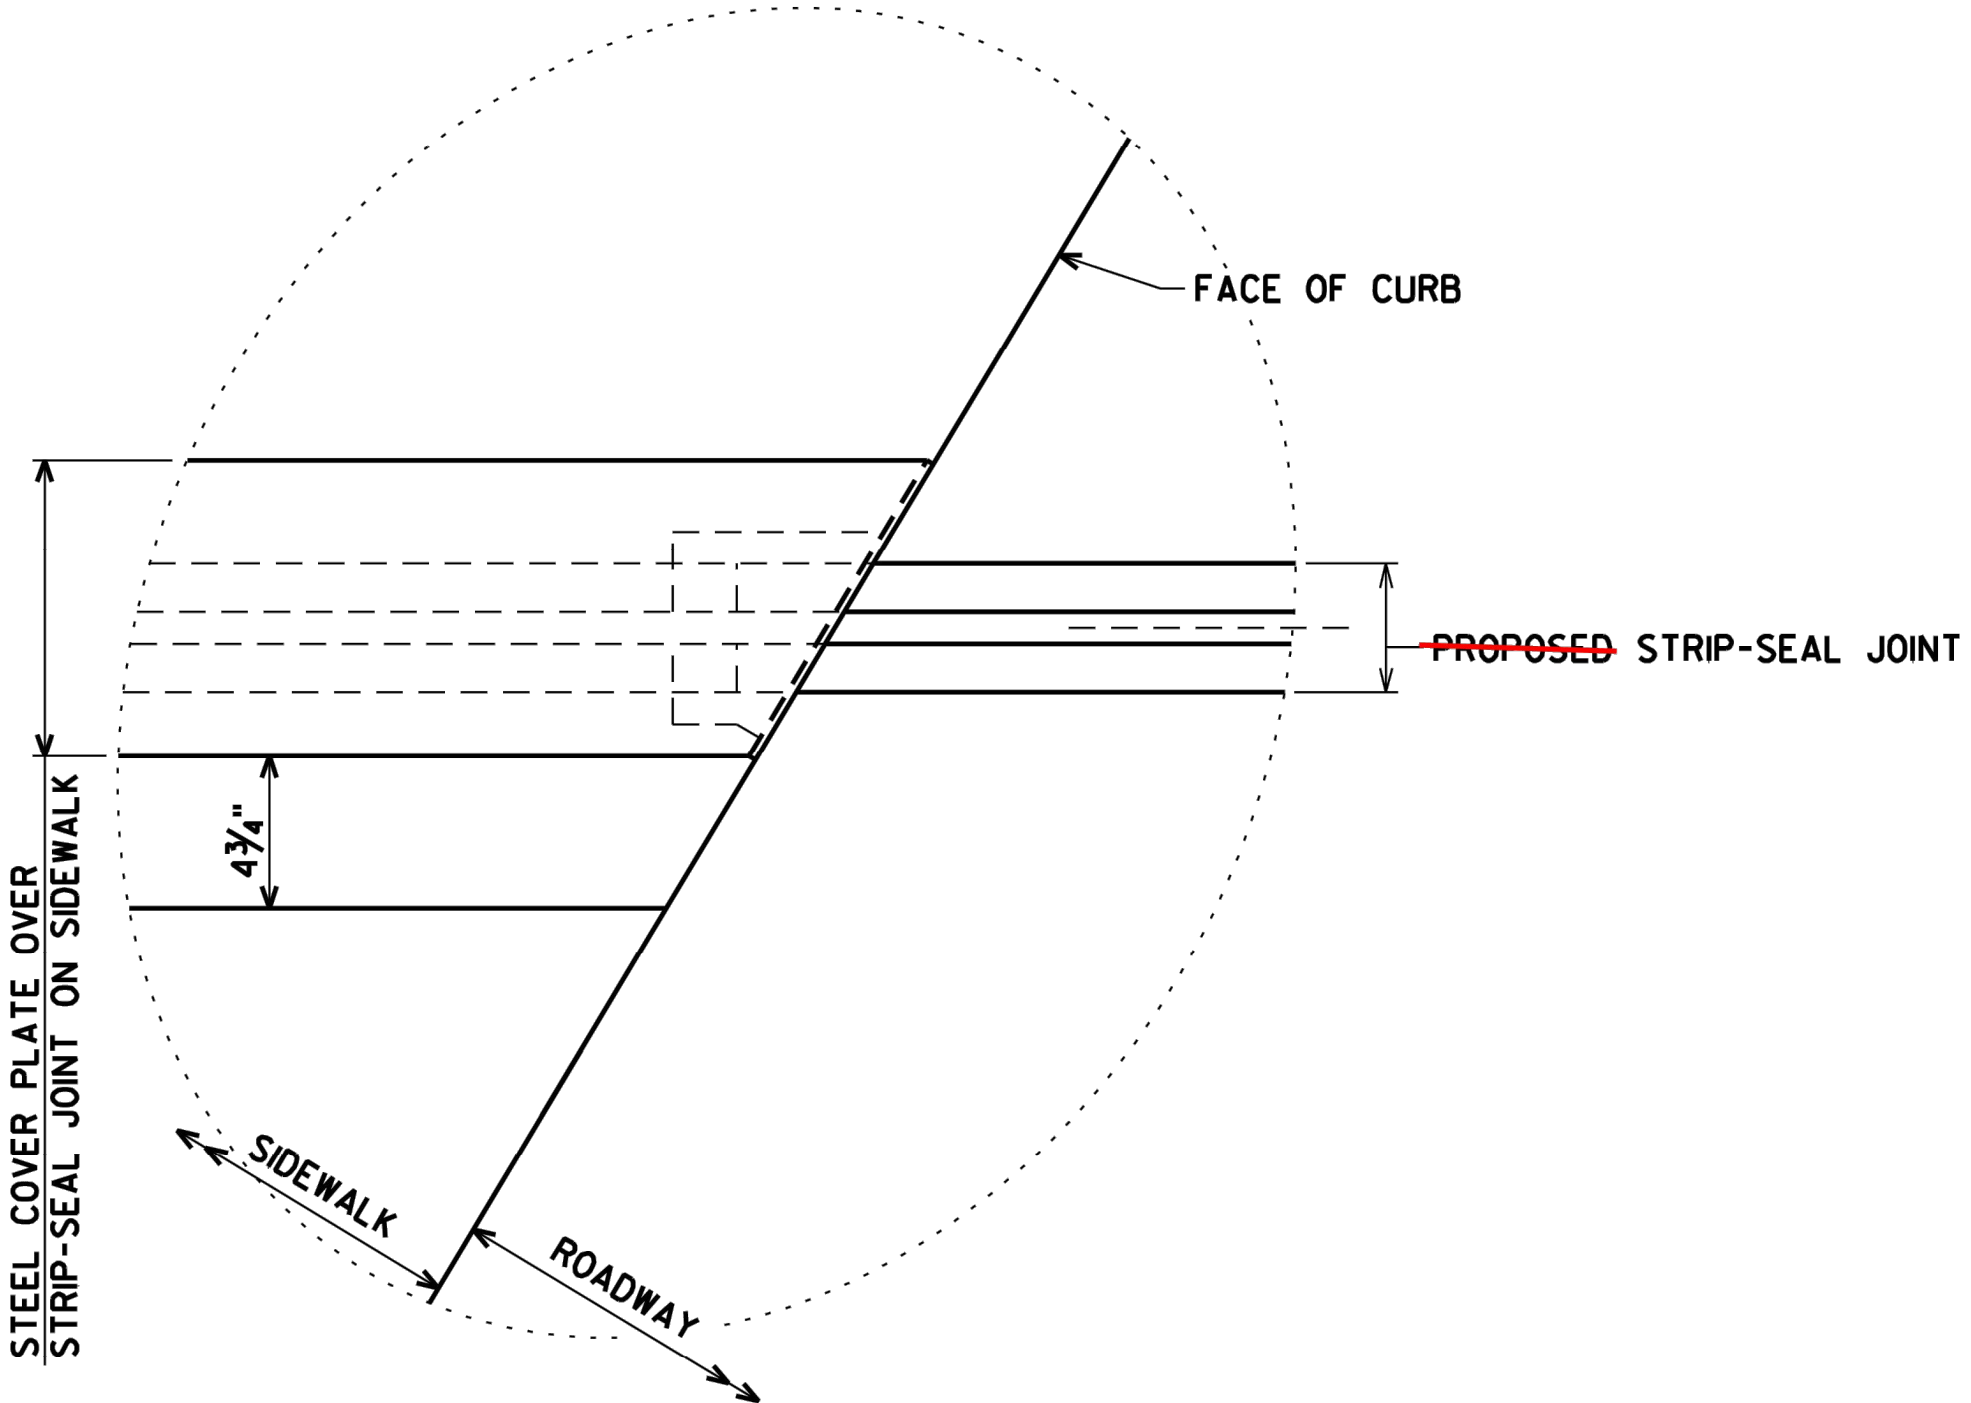

PART PLAN OF SIDEWALK

ISSUED FOR:	CONSTRUCTION	02/20/24
REVISION	DESCRIPTION	DATE

PROJECT NUMBER	PM	AP
770623.0060		
CITY OF SAULT STE MARIE		
SAULT STE MARIE BRIDGE MAINTENANCE		
SAULT STE MARIE, MI		
JOHNSTON ST-EXPANSION JOINT DETAILS		